

MISSISSIPPI DEPARTMENT OF NATURAL RESOURCES

Bureau of Land and Water Resources

Southport Mall

P.O. Box 10631

Jackson, Mississippi 39209 **CODED**

WATER WELL DRILLERS LOG

RANKIN
P102
12-4-95

Dec. 4 1985 E.M. Bud Crosswell Rankin
 date well completed firm name county well located

LANDOWNER:
 Daniel Lacy
 Florence, Ms.
 (mailing address)


description of formations encountered	from	to
	Surface	0
Shale	15	120
lime rock - shale	120	150
Shale	150	180
Sand	180	200

WELL LOCATION:
 sec. 19 T. 4 N. R. 2 E
 1 miles North of Florence
 (distance) (direction) (nearest town)

WELL PURPOSE: Home
 (home, irrigation, municipal, industrial)

- WELL COMPLETION DATA:
- (1) diameter (inches) 4
 - (2) total depth (feet) 200
 - (3) static water level (feet) 80 below above top of ground.
 - (4) casing PVC, 185, (material) (depth)
 4 (size) if telescope see back.
 - (5) screen 15, 185 (length) (depth to top)
 4 (size) PVC (material)
 - (6) pump 1, 12 (HP) (yield gpm)
 - (type power)
 - (7) electric log Yes (yes or no)
 State (organization running log)
 - (8) how well bottom plugged
 cap wash

CODED

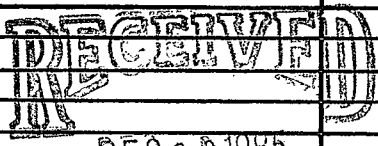


DEC 2 1985

Department of Natural Resources
 Bureau of Land & Water Resources

DRILLERS REMARKS:
 Drilled to 260 ft.

If well telescopes please sketch and show depths.

GROUND LEVEL

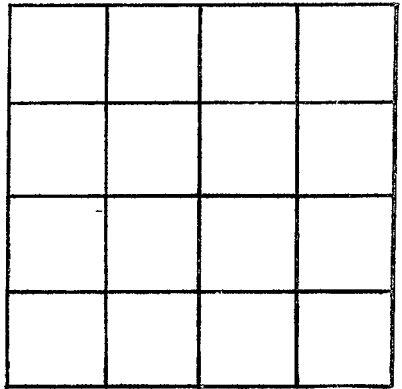

SECTION _____

Please indicate well location X.

ADDITIONAL INFORMATION

If more than one screen, show locations of each on sketch.