

RANKIN
P 2000
12/28/76

MISSISSIPPI
 BOARD OF WATER COMMISSIONERS
 416 North State Street
 Jackson, Mississippi 39201

WATER WELL DRILLERS LOG Rankin

12/28 date well completed 1976 Adcock Waterwellser. firm name Florence county well located

LANDOWNER: Hugh Rushing
Rt 2 Box 193 E
Florence Miss 39073
 (mailing address)

description of formations encountered	from	to
sand & clay	0	40
Rock & clay	40	80
clay	80	120
find sand & clay	120	136
clay	136	160
find sand & clay	160	170
clay	170	200
sand & clay	200	210
sand	210	236

WELL LOCATION:
 sec. 30 T. 4 N. R. 2 E
1 1/2 miles South of Florence
 (distance) (direction) (nearest town)

WELL PURPOSE: Home
 (home, irrigation, municipal, industrial)

WELL COMPLETION DATA:

- (1) diameter (inches) 2
- (2) total depth (feet) 236
- (3) static water level (feet) 150 below top of ground.
- (4) casing GALVA 231,
 (material) (depth)
2 if telescope see back.
 (size)
- (5) screen 5 fut, 236
 (length) (depth to top)
2 Stainless Steel
 (size) (material)
- (6) pump 2 6
 (HP) (yield gpm)
- ELECT.
 (type power)
- (7) electric log NO
 (yes or no)

(organization running log)

(8) how well bottom plugged Shark
Backwash Valve

DRILLERS REMARKS:


RECEIVED
 JAN 27 1977

MISS. BD. OF WATER COMMISSIONERS

Dressed on this

If well telescopes please sketch and show depths.

GROUND LEVEL

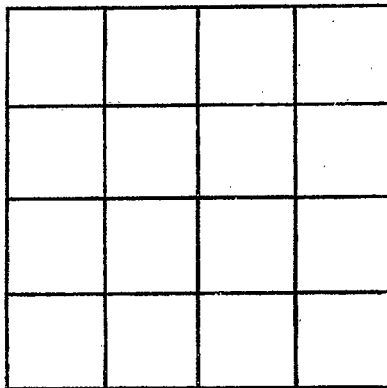

SECTION _____

Please indicate well location X.

ADDITIONAL INFORMATION

If more than one screen, show locations of each on sketch.