

RANKIN MISSISSIPPI BOARD OF WATER COMMISSIONERS

Q11  
9-18-64

Elect LOG - MGS  
WATER WELL DRILLERS LOG

MGS  
Q5  
**CODED**

Date: 9-18, 1964, Driller: James McNeels County: Hinds  
(Name)

(1) Owner of Land: E.E. Ely  
(Name)  
Brendon Mills  
(Address)  
(2) Location: NE 1/4, SE 1/4, Sec. 20 T4N R3E  
7 miles SW of Brendon  
(distance) (direction) (Nearest Town)  
(3) Topography: ✓  
(Hilly) (Flat) (Level)  
(4) Purpose of Well: Domestic  
(Domestic Irrigation  
Municipal, Industrial, Other)

| Description & Color of Materials<br>Sand, Clay, Red Clay, Shell, etc. | Thick-<br>ness<br>Feet | Depth<br>Feet |
|---|------------------------|---------------|
| <u>Surface soil</u>   | <u>5</u>               | <u>5</u>      |
| <u>clay</u>   | <u>15</u>              | <u>20</u>     |
| <u>Blue shale</u>   | <u>60</u>              | <u>80</u>     |
| <u>Grey shale</u>   | <u>40</u>              | <u>120</u>    |
| <u>Grey sh fossils</u>  | <u>28</u>              | <u>148</u>    |
| <u>Red sh fossils</u>   | <u>32</u>              | <u>180</u>    |
| <u>Grey sh fossils</u>  | <u>23</u>              | <u>203</u>    |
| <u>Grey sdy sh</u>  | <u>58</u>              | <u>261</u>    |
| <u>SEND</u>   | <u>13</u>              | <u>274</u>    |
| <u>Grey sdy sh</u>  | <u>2</u>               | <u>276</u>    |
| <u>SEND</u>   | <u>3</u>               | <u>279</u>    |
| <u>Grey sdy sh</u>  | <u>4</u>               | <u>283</u>    |
| <u>SEND</u>   | <u>3</u>               | <u>286</u>    |
| <u>Grey sdy sh</u>  | <u>7</u>               | <u>293</u>    |
| <u>SEND</u>   | <u>4</u>               | <u>297</u>    |
| <u>SEND sh fossils</u>  | <u>41</u>              | <u>338</u>    |
| <u>12 1/2" - 2"</u>   | <u>253</u>             |               |
| <u>1 - -</u>  | <u>19</u>              |               |
| <u>1-2" 008 333</u>   | <u>10</u>              |               |
| <u>1-1/2" 3 BPV</u>   | <u>8</u>               |               |


Information upon completion of well:

(1) Diameter 2 inches.  
(2) Total Depth 335 feet.  
(3) Water Level 57 feet below top of ground.  
(4) Cased to 272, Size \_\_\_\_\_  
(5) Screen: Size 2" 008, Length 10.  
(6) Were any formations sealed against pollution?  
\_\_\_\_\_ yes, ✓ no.

If YES depth of formation \_\_\_\_\_  
Why \_\_\_\_\_

Drillers Remarks: \_\_\_\_\_

**CODED**

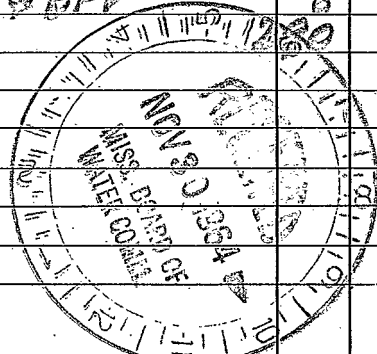

(Use Back Side)

Well No.

1000

1000