

CODED

97

MISSISSIPPI
BOARD OF WATER COMMISSIONERS
416 North State Street
Jackson, Mississippi 39201

WATER WELL DRILLERS LOG

Rankin
Q. 16
6-68
E-109

6-19 1968 Water Well Dr. Co. Rankin
date well completed firm name county well located

LANDOWNER: Lindsay Alison
Rt 2, Brandon
(mailing address)

description of formations encountered	from	to
<u>Red Clay</u>	<u>0</u>	<u>30</u>
<u>Blue Clay</u>	<u>30</u>	<u>45</u>
<u>Sand</u>	<u>45</u>	<u>55</u>

WELL LOCATION: NW, NW
sec. 28 T 4 N R 3 E
S W
4 miles S of Brandon
(distance) (direction) (nearest town)

WELL PURPOSE: Home
(home, irrigation, municipal, industrial)

- WELL COMPLETION DATA:
- (1) diameter (inches) 2"
 - (2) total depth (feet) 55'
 - (3) static water level (feet) 20 ^{below} _{above} top of ground.
 - (4) casing 0 (material) (depth)
(size) if telescope see back.
 - (5) screen 5' 50'
(length) (depth to top)
2" S.S.
(size) (material)
 - (6) pump 3/4 6
(HP) (yield gpm)
Elec.
(type power)
 - (7) electric log yes
(yes or no)
Miss. Well Dr. Co.
(organization running log)

CODED


(8) how well bottom plugged _____

DRILLERS REMARKS: _____

FORM - 3 1968
MISS. BOARD OF
WATER COMM.

If well telescopes please sketch and show depths.

GROUND LEVEL

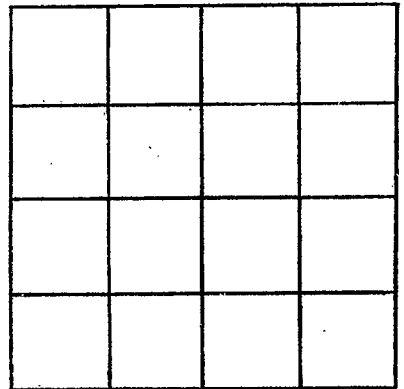

SECTION _____

Please indicate well location X.

ADDITIONAL INFORMATION

If more than one screen, show locations of each on sketch.