

RANKIN

Q 19

3-27-62

MISSISSIPPI BOARD OF WATER COMMISSIONERS

WATER WELL DRILLERS LOG

CODED

Date: Mar. 27, 1962, Driller: W. G. Butler County: Smith

(Name)

(1) Owner of Land: ED. McRae
(Name)
Brandon, Miss.
(Address)

(2) Location: 1/4, 1/4, Sec. 9 T⁴ N R³ E
7 miles South, of Brandon
(distance) (direction) (Nearest Town)

(3) Topography: Level
(Hilly) (Flat) (Level)

(4) Purpose of Well: Domestic
(Domestic Irrigation
Municipal, Industrial, Other)

Description & Color of Materials Sand, Clay, Red Clay, Shell, etc.	Thick- ness Feet	Depth Feet
Chalk	1	12
Sand	12	30
Blue Shale + Chalk	30	70
Rock + Gumbo	70	80
Rock + Sand	80	90
Rock	90	100
Sand	100	120
Gumbo	120	135
Sand	135	145
Licnite	145	150
Shell Sand	150	160
Sand	160	170
Fine Sand	170	200
Fine Sand + Chalk	200	255
Sand	255	295

Information upon completion of well:

(1) Diameter 2 inches.

(2) Total Depth 295 feet.

(3) Water Level 18 feet below top of ground.

(4) Cased to 273, Size 2"

(5) Screen: Size 3", Length 20'


(6) Were any formations sealed against pollution?
no.

If YES depth of formation _____

Why _____

Drillers Remarks: _____

CODED

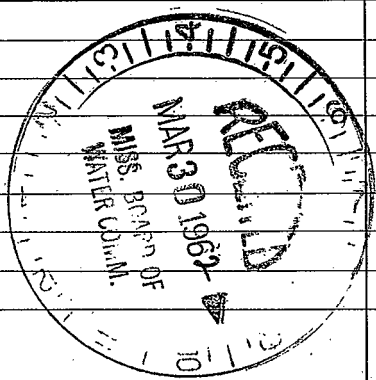

(Use Back Side)

Well No.

