

RANKIN  
Q20  
7-62

MISSISSIPPI BOARD OF WATER COMMISSIONERS

**CODED**

WATER WELL DRILLERS LOG

Date: July, 1962, Driller: MENECE DRILLING Co. County RANKIN  
(Name)


(1) Owner of Land: <u>MR RALPH WILSON</u> (Name)	Description & Color of Materials Sand, Clay, Red Clay, Shell, etc.	Thick- ness Feet	Depth Feet
<u>416 CASEY LANE, JACKSON MISS</u> (Address)	<u>SURFACE SOIL</u>	<u>8</u>	<u>8</u>
(2) Location: <u>1/4, NW 1/4, Sec. 6 T4N R3E</u>	<u>RED SHALE</u>	<u>16</u>	<u>24</u>
<u>5</u> miles <u>S</u> of <u>BRANDON</u> (distance) (direction) (Nearest Town)	<u>BLACK SHALE &amp; ROCK</u>	<u>42</u>	<u>66</u>
(3) Topography: <u>FLAT</u> (Hilly) (Flat) (Level)	<u>ROCK LEDGES</u>	<u>21</u>	<u>87</u>
(4) Purpose of Well: <u>DOMESTIC</u> (Domestic Irrigation Municipal, Industrial, Other)	<u>SHALE &amp; FINE SAND</u>	<u>47</u>	<u>134</u>
	<u>SHALE &amp; SAND</u>	<u>60</u>	<u>194</u>
	<u>SHALE</u>	<u>388</u>	<u>582</u>
	<u>MOODYS BRANCH</u>	<u>26</u>	<u>608</u>
	<u>SHALE</u>	<u>28</u>	<u>636</u>
	<u>FINE SAND</u>	<u>34</u>	<u>670</u>
	<u>FINE SAND &amp; SHALE</u>	<u>80</u>	<u>750</u>
	<u>COARSE SAND</u>	<u>75</u>	<u>825</u>

Information upon completion of well:

- (1) Diameter 4 1/2" inches.
- (2) Total Depth 825 feet.
- (3) Water Level 150 feet below top of ground.
- (4) Cased to 350', Size 4"  
350' - 825' - 2"
- (5) Screen: Size 2", Length 20'.
- (6) Were any formations sealed against pollution?  
no.

Cockfield formation

**CODED**

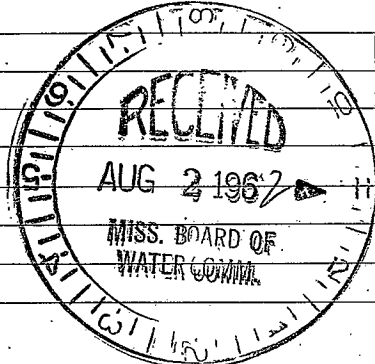

(Use Back Side)

Well No. 38

