

RANKIN

MISSISSIPPI BOARD OF WATER COMMISSIONERS

Q 21

9-26-62

WATER WELL DRILLERS LOG

CODED

Date: Sept 26 19 62, Driller: W. G. Butler County Smith

(Name)

(1) Owner of Land: Caroll Walters  
 (Name)  
Brandon, Miss  
 (Address)

(2) Location: 1/4, 1/4, Sec 29 T4R3,  
1/2 miles South of Brandon  
 (distance) (direction) (Nearest Town)

(3) Topography:  (Hilly)  (Flat)  (Level)

(4) Purpose of Well: Domestic  
 (Domestic Irrigation  
 Municipal, Industrial, Other)

Description & Color of Materials Sand, Clay, Red Clay, Shell, etc.	Thick- ness Feet	Depth Feet
Clay	1-3	
Chalk	3-24	
Rock	24-26	
Blue Chalk	26-38	
Rock + shale	30-50	
shale (blue)	50-60	
shale	60-70	
Fine sand + chalk	70-80	
Chalk	80-100	
Shale	100-110	
Fine sand	110-115	
Shale	115-120	
Rock	120-130	
Fine sand + Chalk	130-140	
Chalk	140-150	
Gumbo	150-160	
Chalk + Fine sand	160-200	
Brown chalk	200-217	
Rock	217-225	
Shell + Sand	225-229	
Rock	229-239	
Rock + Shell	239-260	
Rock + chalk	260-270	
Shell + Sand	270-290	
Sand + chalk	290-300	
Shale + sand	300-310	
Sand + micaite	310-320	
Sand (fine)	320-350	

Information upon completion of well:

(1) Diameter 2 inches.

(2) Total Depth 350 feet.

(3) Water Level 140 feet below top of ground.

(4) Cased to 324, Size 2"


(5) Screen: Size 2", Length 15'

(6) Were any formations sealed against pollution?  
 \_\_\_\_\_ yes, \_\_\_\_\_ no.

If YES depth of formation

Why

Drillers Remarks:

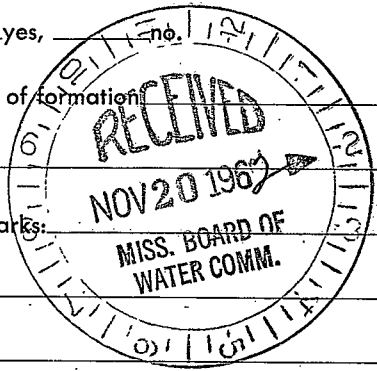

CODED

(Use Back Side)

Well No.

*[Faint, illegible text, possibly bleed-through from the reverse side of the page]*

11  
10  
78