

RAVKIN

P 25
3-63

WATER WELL DRILLERS LOG

Date: March, 1963, Driller: Peepes Drilling Co County: Brandon
(Name)

CODED

(1) Owner of Land: Hersch Hudson
(Name)
Brandon, Miss
(Address)

(2) Location: 1/4, 1/4, Sec. 12 T 4 R
3 1/4 miles N 18
(distance) (direction) (Nearest Town) of Brandon

(3) Topography: Hilly to flat
(Hilly) (Flat) (Level)

(4) Purpose of Well: Domestic
(Domestic Irrigation
Municipal, Industrial, Other)

Description & Color of Materials Sand, Clay, Red Clay, Shell, etc.	Thick- ness Feet	Depth Feet
<u>yellow sandy clay</u>	<u>21</u>	<u>21</u>
<u>gray sandy shale</u>	<u>52</u>	<u>73</u>
<u>limestone</u>	<u>32</u>	<u>105</u>
<u>limestone + sand str.</u>	<u>27</u>	<u>132</u>
<u>gray sand + sandy shale</u>	<u>46</u>	<u>178</u>
<u>brown lignite + sandy shale</u>	<u>53</u>	<u>231</u>
<u>gray sandy shale</u>	<u>42</u>	<u>273</u>
<u>gray quartzite</u>	<u>115</u>	<u>388</u>
<u>gray shale</u>	<u>242</u>	<u>630</u>
<u>gray sand</u>	<u>80</u>	<u>710</u>

Information upon completion of well:

(1) Diameter 4 inches.

(2) Total Depth 710 feet.

(3) Water Level 91 feet below top of ground.

(4) Cased to 412, Size 4"

(5) Screen: Size 2", Length 18'


(6) Were any formations sealed against pollution?
_____ yes, _____ no.

CODED

If YES depth of formation _____

Why _____

Drillers Remarks: _____

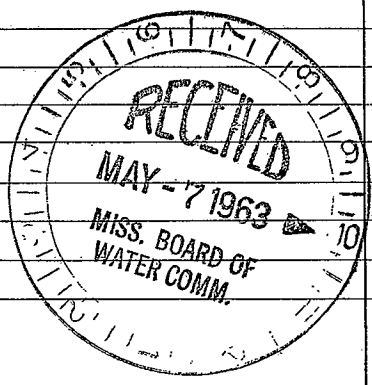

(Use Back Side)

Well No.

100

100

100

100