

RANKIN MISSISSIPPI BOARD OF WATER COMMISSIONERS

Q 27

7-2-65

WATER WELL DRILLERS LOG

CODED

Date: July 2, 1965, Driller: W. H. Butler County: Butts
 (Name)

(1) Owner of Land: Shearner
 (Name)
Brandon MISS
 (Address)

(2) Location: 1/4, 1/4, Sec. 1 T4R3E
5 miles East of Brandon
 (distance) (direction) (Nearest Town)

(3) Topography: (Hilly) (Flat) (Level)

(4) Purpose of Well: Domestic
 (Domestic Irrigation
 Municipal, Industrial, Other)

Description & Color of Materials Sand, Clay, Red Clay, Shell, etc.	Thick- ness Feet	Depth Feet
Rock	1-	50
Rock + Chalk	50-	60
Rock	60-	70
Chalk	70-	80
Sand + Chalk	80-	100
Chalk Rock + sand	100-	120
Chalk	120	130
Chalk + Rock	130	140
Chalk	140	150
Chalk + Rock	150	180
Sand + Chalk	180-	190
Sand	190-	211

Information upon completion of well:

(1) Diameter 2 inches.

(2) Total Depth 211 feet.

(3) Water Level _____ feet below top of ground.

(4) Cased to 194, Size 2"

(5) Screen: Size 2, Length 5'


(6) Were any formations sealed against pollution?
 _____ yes, _____ no.

CODED

If YES depth of formation _____

Why _____

Drillers Remarks: _____

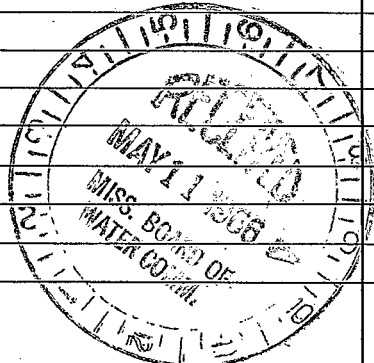

(Use Back Side)

Well No.

Handwritten header text, possibly a date or reference number, at the top of the page.

Main body of handwritten text, appearing as a list or series of entries on the left side of the page.

Handwritten text fragment located in the middle-right section of the page.

Small handwritten text fragment located in the lower-middle section of the page.

Small handwritten text fragment located in the lower-middle section of the page.

Small handwritten text fragment located in the lower-middle section of the page.