

RANKIN

MISSISSIPPI BOARD OF WATER COMMISSIONERS

Q 28

9-14-65

WATER WELL DRILLERS LOG

1465  
94

Date: Sept. 14, 1965, Driller: W.G. Butler Rankin County **CODED**

(1) Owner of Land: R.L. Norris  
(Name)  
Brandon Rt 1 - Miss  
(Address)

(2) Location: 1/4, 1/4, Sec. 2 T4/R5  
\_\_\_\_\_ miles \_\_\_\_\_ of \_\_\_\_\_  
(distance) (direction) (Nearest Town)

(3) Topography:  (Hilly)  (Flat)  (Level)

(4) Purpose of Well: Domestic  
(Domestic Irrigation  
Municipal, Industrial, Other)

| Description & Color of Materials<br>Sand, Clay, Red Clay, Shell, etc. | Thick-<br>ness<br>Feet | Depth<br>Feet |
|---|------------------------|---------------|
| Red Clay + sand   | 1-                     | 10            |
| Chalk + Red sand  | 10-                    | 20            |
| Chalk   | 20-                    | 95            |
| Rock  | 95-                    | 130           |
| Rock + shell  | 130-                   | 140           |
| Shell   | 140-                   | 150           |
| Shell + sand  | 150-                   | 160           |
| Shell + Lignite   | 160-                   | 170           |
| Shell + Chalk   | 170-                   | 201           |
| gray chalk  | 201-                   | 211           |
| sand, Chalk + Lignite   | 211-                   | 219           |
| sand + chalk  | 219-                   | 269           |
| chalk   | 269-                   | 279           |
| Shell + Chalk   | 279-                   | 289           |
| Chalk + shell   | 289-                   | 430           |
| Blue shell  | 430-                   | 569           |
| Rock + Blue shell   | 569-                   | 607           |
| Rock  | 607-                   | 618           |
| Rock + Chalk  | 618-                   | 629           |
| shell + sand  | 629-                   | 638           |
| sand shell Rock   | 638-                   | 648           |
| sand shell  | 648-                   | 658           |
| sand  | 658-                   | 688           |
| sand + shell  | 688-                   | 698           |
| sand  | 698-                   | 728           |

Information upon completion of well:

(1) Diameter 2" inches.

(2) Total Depth 728 feet.

(3) Water Level \_\_\_\_\_ feet below top of ground. 213' - 4"

(4) Cased to 660-, Size 2"

(5) Screen: Size 2", Length 20'


(6) Were any formations sealed against pollution?  
\_\_\_\_\_ yes, \_\_\_\_\_ no.

If YES depth of formation \_\_\_\_\_

Why \_\_\_\_\_

Drillers Remarks: \_\_\_\_\_

**CODED**

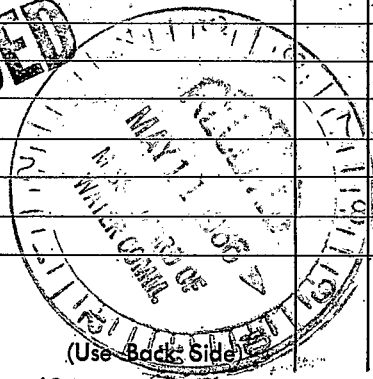

(Use Back Side)

Well No.

Handwritten text at the top of the page, possibly a title or header.

Handwritten text in the upper middle section.

Handwritten text in the middle right section.

Handwritten text in the lower middle section.



A small handwritten mark or character at the bottom center.