

E LOG # 229

CODED

Rankin
Q 34
8-11-69
M. G. S.

MISSISSIPPI
BOARD OF WATER COMMISSIONERS
416 North State Street
Jackson, Mississippi 39201

CODED

WATER WELL DRILLERS LOG

aug 11, 1969 19 R. E. Thompson Rankin
date well completed firm name county well located

LANDOWNER:

Juanita Buchholz
Boonville Miss.
(mailing address)

description of formations encountered

from

to

sand rock 0 15
Blue clay 15 250
lim stone 250 300
thinner with sand shells 300 315
Brown clay 315 320
sand & silt 320 417

WELL LOCATION:

sec. 29 T 4 N R 3 E
33 8
2 miles S/E of Thomsonville
(distance) (direction) (nearest town)

WELL PURPOSE: home
(home, irrigation, municipal, industrial)

WELL COMPLETION DATA:

- (1) diameter (inches) 2 1/2
- (2) total depth (feet) 417
- (3) static water level (feet) 100 below top of ground.
- (4) casing PVC, 2 1/2' (material) (depth),
2 1/2" (size) if telescope see back.
- (5) screen open (length), (depth to top)
(size) (material)
- (6) pump 3/4 (HP) 5 (yield gpm)
Just Withair-18 (type power)
- (7) electric log yes (yes or no)
M. G. S. (organization running log)
- (8) how well bottom plugged open

CODED


DRILLERS REMARKS:

sand would stop
screen up

SEP 12 1969
MISS. REG. OFF.
ENGINEERING

If well telescopes please sketch and show depths.

GROUND LEVEL

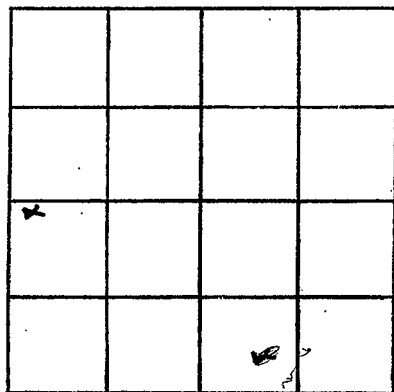

SECTION 33
~~27~~

Please indicate well location X.

ADDITIONAL INFORMATION

If more than one screen, show locations of each on sketch.