

ELOG # 287

RANKIN

Q37

1-15-71

MISSISSIPPI BOARD OF WATER COMMISSIONERS
416 North State Street
Jackson, Mississippi 39201

CODED

WATER WELL DRILLERS LOG

Jan 15 1971 Griner Drilling Rankin
date well completed firm name county well located

LANDOWNER: H & P Drilling Co.
Working for Shell Oil Co
Do not know about landowner
(mailing address)

description of formations encountered	from	to
hard clay	0	230
fine sand with streaks of clay	230	290
clay	290	310
fine sand	310	330
clay	330	340
fine sand	340	350
clay with streaks of rocks & shale	350	930
fine sand with small slate fragments	930	1000

WELL LOCATION: 1800 5th 15th W of NE/cor.
sec 32 T 4 N R 3 E
Dec 32-4N-3E
miles _____ of _____
(distance) (direction) (nearest town)

WELL PURPOSE: TWIN
(home, irrigation, municipal, industrial)

WELL COMPLETION DATA:

- (1) diameter (inches) 3"
- (2) total depth (feet) 1000
- (3) static water level (feet) _____ below/above top of ground.
- (4) casing 3" steel
(material) (depth)

CODED

- (5) slotted pipe (size) 7.5" (length) 925 to 1000 (depth to top)
- 3" pipe steel (size) (material)
- (6) pump air lift with surface line (HP) 65 (yield gpm)
at 560 (type power)

JAN 22 1971

(7) electric log yes (yes or no)
Miss. Geo. Survey (organization running log)


MISS. DEPT. OF WATER COMM.

(8) how well bottom plugged welded

DRILLERS REMARKS:

If well telescopes please sketch and show depths.

GROUND LEVEL

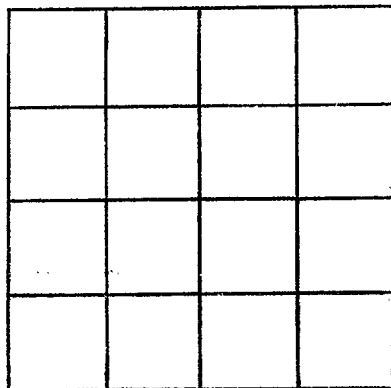

SECTION _____

Please indicate well location X.

ADDITIONAL INFORMATION

If more than one screen, show locations of each on sketch.