

**RANKIN**  
**Q 39**  
**11-23-70**

MISSISSIPPI  
 BOARD OF WATER COMMISSIONERS  
 416 North State Street  
 Jackson, Mississippi 39201

**CODED**

**WATER WELL DRILLERS LOG**

Nov. 23 1970 W. E. Theysen Rankin  
 date well completed firm name county well located

LANDOWNER:  
Charlie Minner  
B. Foster Minner  
 (mailing address)

WELL LOCATION:  
 sec 33 T 4 N R 3 E  
1 miles S 1/2 of Shawville  
 (distance) (direction) (nearest town)

WELL PURPOSE: Home  
 (home, irrigation, municipal, industrial)

- WELL COMPLETION DATA:
- (1) diameter (inches) 2"
  - (2) total depth (feet) 360'
  - (3) static water level (feet) 130' below above top of ground.
  - (4) casing Galv. 210'  
 (material) (depth)  
2"  
 (size) if telescope see back.
  - (5) screen open  
 (length) (depth to top)  
 (size) (material)
  - (6) pump 1 1/2 6  
 (HP) (yield gpm)  
Jet  
 (type power)
  - (7) electric log \_\_\_\_\_  
 (yes or no)  
 (organization running log)
  - (8) how well bottom plugged open

description of formations encountered	from	to
<u>top soil &amp; rock</u>	<u>0</u>	<u>15"</u>
<u>15' blue clay</u>	<u>15"</u>	<u>290</u>
<u>thin blue</u>		
<u>Brown clay</u>	<u>290</u>	<u>300</u>
<u>hard &amp; shaly</u>	<u>300</u>	<u>320</u>
<u>Brown clay</u>	<u>320</u>	<u>360</u>

**CODED**


**DEC 16 1970**

DRILLERS REMARKS:

MISS. BD. OF  
 WATER COMM.

If well telescopes please sketch and show depths.

GROUND LEVEL

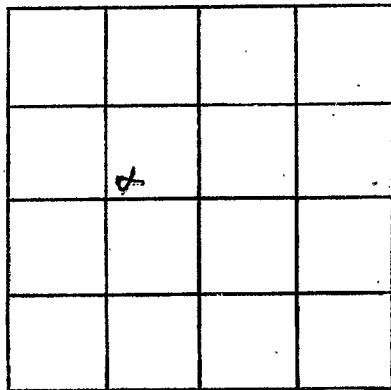

SECTION 33

Please indicate well location X.

ADDITIONAL INFORMATION

If more than one screen,  
show locations of each on sketch.