

50

log # 380

CODED

~~Q 51~~  
RANKIN

6-21-73

MISSISSIPPI  
BOARD OF WATER COMMISSIONERS  
416 North State Street  
Jackson, Mississippi 39201

WATER WELL DRILLERS LOG

June 21 19 73

R. E. Thompson

Rankin

date well completed

firm name

county well located

LANDOWNER: R.B.

Rev. Johnson, Jr

(mailing address)

description of formations encountered

from

to

|               |    |     |
|---------------|----|-----|
| top soil      | 0  | 15  |
| sand          | 15 | 24  |
| pink clay     | 24 | 30  |
| strip of sand | 30 | 82  |
| sand          | 82 | 136 |

WELL LOCATION:

sec. 5 T. 4 N. R. 3 E

3 miles S of Brandon  
(distance) (direction) (nearest town)

CODED

WELL PURPOSE:

(home, irrigation, municipal, industrial)

WELL COMPLETION DATA:


- (1) diameter (inches) 2"
- (2) total depth (feet) 136
- (3) static water level (feet) 54 below above  
top of ground.
- (4) casing plastic, 106,  
(material) (depth)  
2"  
(size) if telescope see back.
- (5) screen 10' 106  
(length) (depth to top)  
2", plastic  
(size) (material)
- (6) pump 1 12  
(HP) (yield gpm)  
120  
(type power)
- (7) electric log yes  
(yes or no)  
M. H. S.  
(organization running log)
- (8) how well bottom plugged \_\_\_\_\_

DRILLERS REMARKS:

AUG 13 1973

If well telescopes please sketch and show depths.

GROUND LEVEL

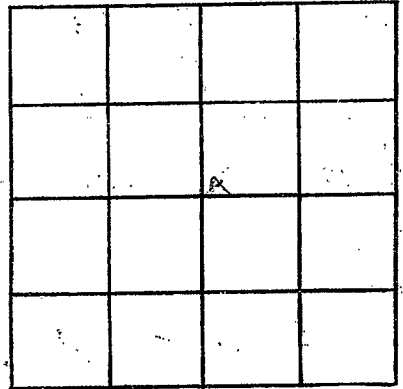

SECTION 5

Please indicate well location X.

ADDITIONAL INFORMATION

If more than one screen,  
show locations of each on sketch.