

RANKIN
Q52
10-28-73

MISSISSIPPI
 BOARD OF WATER COMMISSIONERS
 416 North State Street
 Jackson, Mississippi 39201

CODED

WATER WELL DRILLERS LOG

Oct 28 1973 W. G. Butler Rankin
 date well completed firm name county well located

LANDOWNER:
Vernon Ross
Braxton Miss. Rte.
 (mailing address)

WELL LOCATION:
 sec. 25 T 4 N R. 3 S
6 miles SE of Braxton
 (distance) (direction) (nearest town)

WELL PURPOSE: Home
 (home, irrigation, municipal, industrial)

WELL COMPLETION DATA:

(1) diameter (inches) 2

(2) total depth (feet) 168

(3) static water level (feet) _____ below
 top of ground. above

(4) casing galv., 161,
 (material) (depth)
2" if telescope see back.
 (size)

(5) screen 5', 161
 (length) (depth to top)
2", S.S.
 (size) (material)

(6) pump _____ (HP) _____ (yield gpm)
Electric
 (type power)

(7) electric log No
 (yes or no)

 (organization running log)

(8) how well bottom plugged 2" B.W.


description of formations encountered	from	to
Clay + Rock	0	10
Rock	10	30
Clay + Rock	30	40
Fine Sand Clay + Rock	40	50
Sand + Rock	50	55
Clay + Rock	55	70
Fine Sand + Clay	70	80
Clay	80	90
Rock + Clay	90	100
Rock + clay	100	110
Clay + Fine Sand	110	120
Clay + Sand	120	130
Clay	130	150
Sand	150	168

NOV 28 1973
 MISS. Bd. OF
 WATER COMMISSIONERS

DRILLERS REMARKS:

If well telescopes please sketch and show depths.

GROUND LEVEL

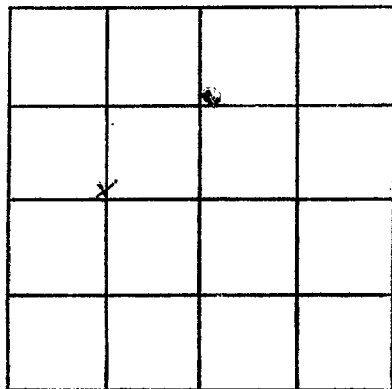

SECTION 25

Please indicate well location X.

ADDITIONAL INFORMATION

If more than one screen,
show locations of each on sketch.