

RANKIN
 Q 53
 8/15/74
 E.L. #462

MISSISSIPPI
 BOARD OF WATER COMMISSIONERS
 416 North State Street
 Jackson, Mississippi 39201

380
 175
 205
 7/15
 882
 7/15
 101

CODED

WATER WELL DRILLERS LOG

8/15/74 19 W. E. Thomas Rankin
 date well completed firm name county well located

LANDOWNER:
Jahn Mc-Afee
Boarder Min.
 (mailing address)

description of formations encountered	from	to
<u>top soil</u>	<u>0</u>	<u>10</u>
<u>hard clay</u>	<u>10</u>	<u>60</u>
<u>Blue clay</u>	<u>60</u>	<u>80</u>
<u>Yellowish sand</u>	<u>80</u>	<u>140</u>
<u>Blue clay</u>	<u>140</u>	<u>190</u>
<u>hard shells</u>	<u>190</u>	<u>240</u>
<u>clay down</u>	<u>240</u>	<u>265</u>

WELL LOCATION:
 sec 20 T 4 N R 3 E
3 miles E of Thomas
 (distance) (direction) (nearest town)

WELL PURPOSE: home
 (home, irrigation, municipal, industrial)

- WELL COMPLETION DATA:
- (1) diameter (inches) 2"
 - (2) total depth (feet) 265'
 - (3) static water level (feet) 65' below above top of ground.
 - (4) casing Plute 150' (material) (depth)
2" (size) if telescope see back.
 - (5) screen open hole (length) (depth to top)
 (size) (material)
 - (6) pump 1 (HP) 6 (yield gpm)
 - (7) electric log yes (yes or no)
M. S. S. (organization running log)
 - (8) how well bottom plugged open

CODED

RECEIVED


OCT 2 1974

DRILLERS REMARKS:

MISS. RD. OF WATER COMM

If well telescopes please sketch and show depths.

GROUND LEVEL

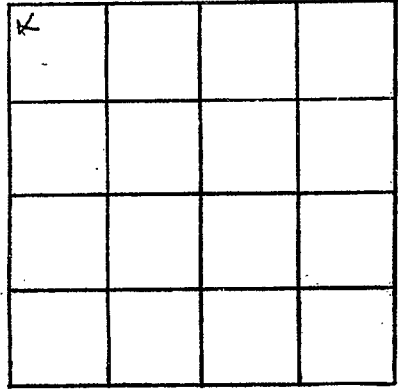

SECTION 26

Please indicate well location X.

ADDITIONAL INFORMATION

If more than one screen, show locations of each on sketch.