

RANKIN
 Q 55
 7177
 E 438

MISSISSIPPI
 BOARD OF WATER COMMISSIONERS
 416 North State Street
 Jackson, Mississippi 39201

CODED

WATER WELL DRILLERS LOG

7-1977 **GRINER DRILLING SERVICE** RANKIN
 date well completed firm name county well located

LANDOWNER: **HUNT ENERGY**
CORP. #1 KENNEDY
 (mailing address)
 WELL LOCATION: **NEA 24 N 1/4**
 sec. **3A** T. **4N** S. R. **3E** W.
 _____ miles _____ of _____
 (distance) (direction) (nearest town)

description of formations encountered	from	to
Top soil	0	3
CLAY + SAND streaks	3	100
CLAY	100	110
SAND w/CLAY streaks	110	148
CLAY	148	240
Rocks	240	270
SAND w/CLAY streaks	270	400
CLAY/ROCK streaks	400	700
SAND	700	730
CLAY	730	1016
SAND	1016	1055

WELL PURPOSE: **oil well 5000'**
 (home, irrigation, municipal, industrial)

WELL COMPLETION DATA:
 (1) diameter (inches) 3"
 (2) total depth (feet) 1060
 (3) static water level (feet) 150' below above top of ground.
 (4) casing steel 1018
 (material) (depth)
3" If telescope see back.
 (size)
 (5) screen 42 1018
 (length) (depth to top)
3" slotted pipe (Houston)
 (size) (material)
 (6) pump NO 65
 (HP) (yield gpm)
AIR COMPRESSOR
 (type-power)
 (7) electric log Yes
 (yes or no)
Miss. Geol. Survey
 (organization running log)
 (8) how well bottom plugged Back Wash

CODED


RECEIVED
LAB
AUG 8 1977

MISSISSIPPI BOARD OF WATER COMMISSIONERS

DRILLERS REMARKS:

If well telescopes please sketch and show depths.

GROUND LEVEL

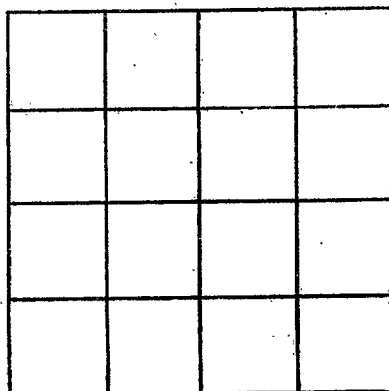

SECTION _____

Please indicate well location X.

ADDITIONAL INFORMATION

If more than one screen, show locations of each on sketch.