

RANKIN
 56
 12/23/77
 Elec # 442
 12/23/77
 date well completed

MISSISSIPPI
 BOARD OF WATER COMMISSIONERS
 416 North State Street
 Jackson, Mississippi 39201

CODED
 RECEIVED

WATER WELL DRILLERS LOG

Griner Drilling Service Rankin Co.
 firm name county well located

LANDOWNER: Shell Oil Co
 M.F. Spangler and #1
 (mailing address)

description of formations encountered from to
 See Log Enclosed

WELL LOCATION:
 sec. 21 T. 4 N R. 3 E
 1500' N + 2200' E of SW Cor. of SE 1/4
 3 miles (distance) S of SE (direction) of Star (nearest town)

WELL PURPOSE:
 (home, irrigation, municipal, industrial)


- WELL COMPLETION DATA:
- (1) diameter (inches) 3"
 - (2) total depth (feet) 1081
 - (3) static water level (feet) 140' below top of ground.
 - (4) casing Steel 890' (material) (depth)
 - (size) If telescope see back.
 - (5) screen 40' 850' (length) (depth to top)
 3" Stainless Steel (size) (material)
 - (6) pump AC 170 (HP) (yield gpm)
 AC (type power)
 - (7) electric log yes (yes or no)
 MS Geo Survey (organization running log)
 - (8) how well bottom plugged Back Wash Valve

DRILLERS REMARKS:
 Ron Deemer

RECEIVED
 JAN 17 1978

If well telescopes please sketch and show depths.

GROUND LEVEL

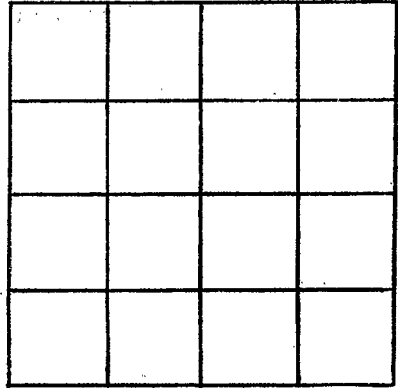

SECTION _____

Please indicate well location X.

ADDITIONAL INFORMATION

If more than one screen, show locations of each on sketch.