

RANKIN

①-3559

8-28-78

MISSISSIPPI
 BOARD OF WATER COMMISSIONERS CODED
 416 North State Street
 Jackson, Mississippi 39201

WATER WELL DRILLERS LOG

8-28-78 Griner Drilling Rankin
 date well completed firm name county well located

LANDOWNER:

Pursue Energy

(mailing address)

WELL LOCATION:

sec 35 T 4 N R 3 E
 S W
 Thomasville Unit
 (distance) (direction) (nearest town)

WELL PURPOSE: DIT field supply
 (home, irrigation, municipal, industrial)

WELL COMPLETION DATA:

- (1) diameter (inches) 3"
- (2) total depth (feet) 1250'
- (3) static water level (feet) 150 ^{below} top of ground.
- (4) casing steel, 1250'
 (material) (depth)
3"
 (size) if telescope see back.
- (5) screen 42', 1208'
 (length) (depth to top)
3", perforated
 (size) (material)
- (6) pump —, 75-80
 (HP) (yield gpm)
AC
 (type power)
- (7) electric log —
 (yes or no)
 (organization running log)
- (8) how well bottom plugged orange
peel

DRILLERS REMARKS:

description of formations encountered

from

to

sand + rock	0	21
clay + rock	21	270
streaked sand in place	210	400
clay	400	900
streaked	900	950
streaked with sand and shell	950	1250


CODED

RECEIVED
 SEP - 7 1978

MISS. BD. OF WATER COMMISSIONERS

If well telescopes please sketch and show depths.

GROUND LEVEL

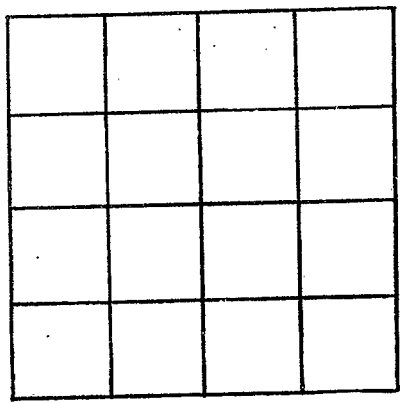

SECTION _____

Please indicate well location X.

ADDITIONAL INFORMATION

A series of horizontal lines for recording additional information, starting below the 'ADDITIONAL INFORMATION' header and extending to the bottom of the page.

If more than one screen, show locations of each on sketch.