

Rankin  
 Q 61  
 11/4/79  
 Log #493  
 11-4

MISSISSIPPI  
 BOARD OF WATER COMMISSIONERS  
 416 North State Street  
 Jackson, Mississippi 39201

CODED

WATER WELL DRILLERS LOG

for Rankin

date well completed 11-4-1979 firm name Laurel Central Company county well located Rankin

LANDOWNER: Kennel Energy  
The Artloff Company  
Brandon, Miss.  
 (mailing address)

WELL LOCATION:  
 sec. 34 T 4 N R 3 E  
 (distance) miles (direction) of (nearest town)

WELL PURPOSE: Industrial  
 (home, irrigation, municipal, industrial)

- WELL COMPLETION DATA:
- (1) diameter (inches) 8 x 4
  - (2) total depth (feet) 1081'
  - (3) static water level (feet) 206 below above top of ground.
  - (4) casing Steel, 431' (material) (depth)  
8 if telescope see back.  
 (size) ends 610' of 4"
  - (5) screen 40', 1041' (length) (depth to top)  
4", Stainless Steel (size) (material)
  - (6) pump 20 125 (HP) (yield gpm)  
Electric (type power)
  - (7) electric log yes (yes or no)  
Miss. Geo. Survey (organization running log)
  - (8) how well bottom plugged None

description of formations encountered	from	to
Clay	0	4
Line Rock	4	18
Clay	18	122'
Sandy Clay	122'	138'
Clay	138	218
Sandy Clay	218	252
Rock	252	258
Clay	258	263
Rock	263	265
Clay & Line Rock Strata	265	277
Hard Clay	277	557
Sandy Shale	557	580
Clay	580	630
Sandy Shale	630	682
Hard Clay	682	760
Sandy Shale	760	835
Sand & Shale Strata	835	898
Shale	898	935
Sandy Shale	935	1048
Sand	1048	1082
Clay	1082	1090
Sand & Lignite	1090	1149

CODED

DEPT. OF NATURAL RESOURCES  
 BUREAU OF LAND & WATER RESOURCES

NOV 13 1979


RECEIVED

DRILLERS REMARKS:

(7)

If well telescopes please sketch and show depths.

GROUND LEVEL

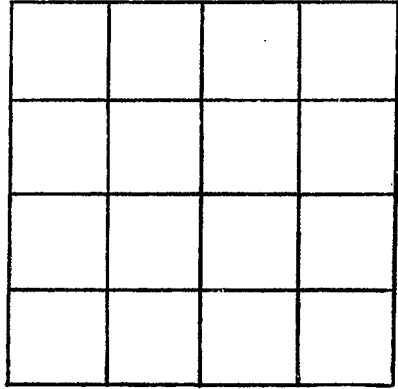

SECTION \_\_\_\_\_

Please indicate well location X.

ADDITIONAL INFORMATION

A series of horizontal lines for writing additional information, starting below the 'ADDITIONAL INFORMATION' header and extending to the bottom of the page.

If more than one screen, show locations of each on sketch.