

MISSISSIPPI DEPARTMENT OF NATURAL RESOURCES

Bureau of Land and Water Resources

Southport Mall

P.O. Box 10631

Jackson, Mississippi 39209

WATER WELL DRILLERS LOG

CODED

Rankin
Q-602
6/30/80

#504

June '80
 date well completed

80 E. M. Bud Cresswell
 firm name

Rankin
 county well located

LANDOWNER:
Pursue Energy Co.
Houston TEXAS
 (mailing address)

| description of formations encountered | from | to |
|---------------------------------------|------------|------------|
| <u>Clay</u> | <u>0</u> | <u>200</u> |
| <u>Clay rock</u> | <u>200</u> | <u>240</u> |
| <u>Clay</u> | <u>240</u> | <u>750</u> |
| <u>Sand</u> | <u>750</u> | <u>925</u> |

WELL LOCATION:
 sec. 26 T 4 N R 3 E
SE NW 3
3 miles South of Kennettville
 (distance) (direction) (nearest town)

WELL PURPOSE: Industrial
 (home, irrigation, municipal, industrial)

CODED

- WELL COMPLETION DATA:
- (1) diameter (inches) 6 x 4
 - (2) total depth (feet) 925
 - (3) static water level (feet) 180 below above top of ground.
 - (4) casing Steel 985 885
 (material) (depth)
 - 6 if telescope see back. 885
 (size)
 - (5) screen 40 985
 (length) (depth to top)
 - 4 STAINLESS
 (size) (material)
 - (6) pump 15 100
 (HP) (yield gpm)
 - (type power)
 - (7) electric log yes
 (yes or no)
 - State
 (organization running log)
 - (8) how well bottom plugged
dent - shark

DEPT. OF NATURAL RESOURCES
 BUREAU OF LAND & WATER RESOURCES

JUL 29 1980


RECEIVED

DRILLERS REMARKS:



If well telescopes please
sketch and show depths.

GROUND LEVEL

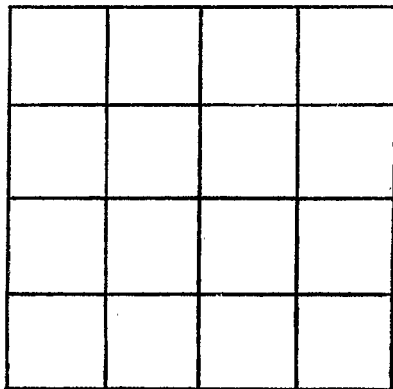

SECTION _____

Please indicate well location X.

ADDITIONAL INFORMATION

If more than one screen,
show locations of each on sketch.