

MISSISSIPPI DEPARTMENT OF NATURAL RESOURCES

Bureau of Land and Water Resources

Southport Mall

P.O. Box 10631

Jackson, Mississippi 39209

WATER WELL DRILLERS LOG

CODED


RANKIN
Q 65
3-24-81

March 24 1981 E.M. "Bud" Cresswell RANKIN
date well completed firm name county well located

LANDOWNER:	description of formations encountered	from	to
<u>PURSUE Energy Corp.</u> <u>Hopkins Location</u> <u>Lafayette, La.</u> (mailing address)			
WELL LOCATION:			
<u>sec. 25</u> T <u>4</u> N R <u>3</u> E			
<u>4</u> miles <u>South</u> <u>Thomasville</u>			
(distance) (direction) (nearest town)			
WELL PURPOSE: <u>Industrial</u> (home, irrigation, municipal, industrial)			
WELL COMPLETION DATA:			
(1) diameter (inches) <u>3</u>			
(2) total depth (feet) <u>230</u>			
(3) static water level (feet) <u>100</u> below top of ground.			
(4) casing <u>steel</u> <u>210</u>			
(material) (depth)			
<u>3</u> if telescope see back.			
(size)			
(5) screen <u>20</u> <u>210</u>			
(length) (depth to top)			
<u>3</u> <u>Stainless</u>			
(size) (material)			
(6) pump <u>air Comp.</u>			
(HP) (yield gpm)			
(type power)			
(7) electric log <u>No</u>			
(yes or no)			
(organization running log)			
(8) how well bottom plugged <u>Disk wash valve</u>			

This descrip. of Thomasville well on both E of

CODED

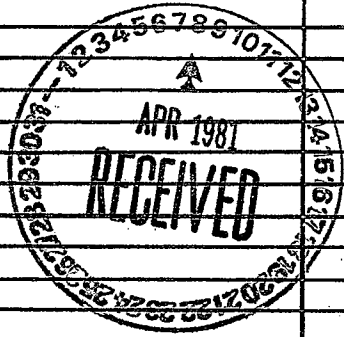

MISSISSIPPI DEPARTMENT OF NATURAL RESOURCES
BUREAU OF LAND & WATER RESOURCES


APR - 8 1981

RECEIVED

DRILLERS REMARKS:

If well telescopes please
sketch and show depths.

GROUND LEVEL

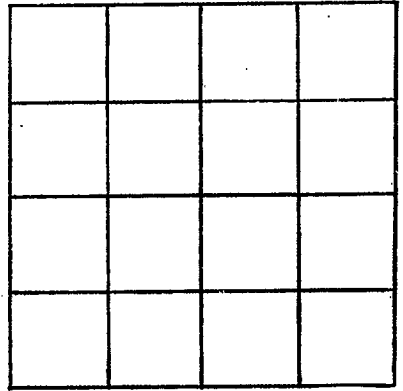

SECTION _____

Please indicate well location X.

ADDITIONAL INFORMATION

If more than one screen,
show locations of each on sketch.