

MISSISSIPPI DEPARTMENT OF NATURAL RESOURCES

Bureau of Land and Water Resources

Southport Mall

P.O. Box 10631

Jackson, Mississippi 39209

WATER WELL DRILLERS LOG

CONFIDENTIAL

**RANKIN**  
**Q 66**  
**3-25-81**

March 25 1981 date well completed      E.M. "Bud" Russell Rankin firm name      county well located

LANDOWNER:  
Pursue Energy Corp.  
Hopkins Location  
La Fayette, La.  
 (mailing address)

description of formations encountered	from	to
<u>Shale</u>	<u>0</u>	<u>140</u>
<u>Sand</u>	<u>140</u>	<u>210</u>

WELL LOCATION:  
 sec 25 T 4 N R 3 E  
4 miles South of Knoxville  
 (distance) (direction) (nearest town)

CODED

WELL PURPOSE: Industrial  
 (home, irrigation, municipal, industrial)

WELL COMPLETION DATA:

(1) diameter (inches) 3

(2) total depth (feet) 210

(3) static water level (feet) 100 below top of ground.

(4) casing Steel 190  
 (material) (depth)

3 (size) if telescope see back.

(5) screen 20 190  
 (length) (depth to top)


2 Stainless  
 (size) (material)

(6) pump Air Comp  
 (HP) (yield gpm)

(type power)

(7) electric log No  
 (yes or no)

(organization running log)

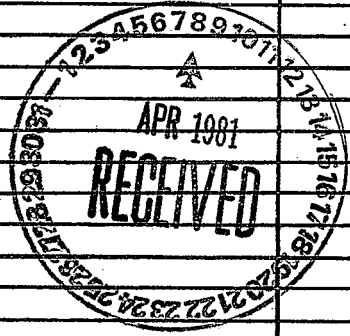

(8) how well bottom plugged  
back wash

DRILLERS REMARKS:


DEPT OF NATURAL RESOURCES  
 BUREAU OF LAND & WATER RESOURCES

APR - 8 1981

RECEIVED

If well telescopes please  
sketch and show depths.

GROUND LEVEL

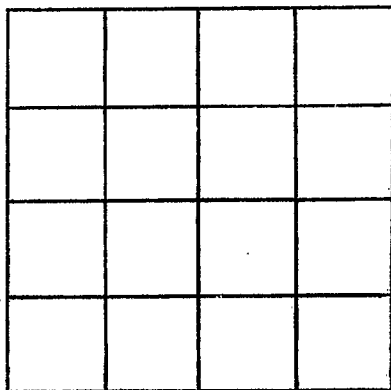

SECTION \_\_\_\_\_

Please indicate well location X.

ADDITIONAL INFORMATION

If more than one screen,  
show locations of each on sketch.