| | XX7.11 Demont | |
|---|-------------------------------------|--|
| | Part 1 | For Office Use Only: |
| County: Kankin Mississippi Depart | ment of Environmental Quality | Aquifer: |
| Permit # Office of La | nd and Water Resources | Well #: Q 82 |
| Gran Dauhara P. | O. Box 10631 | L. S. Elevation: |
| Date drilling completed: $7 - 2 - 08$ (60) | n, MS 39289-0631 601)961-5210 | |
| Date drilling completed: 1 2 0 0 (60) | 1)354-6938 (fax) | E-log #: |
| State Law requires that this report be prepared by | - | |
| 30 days of completion of drilling of the well. Well Owner Information | We | II Location |
| owner Name Melba Smith | Latitude:°' | " Longitude:°' |
| Mailing Address: 218 Peter MCAFee Dr | Method of Lat/Long (circle of | one): Conventional Survey, |
| ······································ | | d GPS, Survey-grade GPS |
| Brandon MS 39042 | 1414 Sec_2 | <u>3 _{Twn} 4N _{Rng} 3E</u> |
| City State Zip Code | Distance Direction | Nearest Town |
| Telephone No. (601) 845 - 8455 | _102 | of Brandon |
| | Well Data | |
| Purpose of Well (circle one Home Industrial Public Sur | oply Irrigation Fish Culture | Other: |
| Date well drilling started: 7-2-08 | Date well drilling completed: | -2-08 |
| If flowing, method of flow regulation: Valve O | ther (describe) | |
| Static Water Level:feet above or below (circle | one) land surface Date measured | 1: 7-2.08 |
| | | |
| | | <u>-</u> |
| Hole depth: 70' Well depth: 68' | Well grouted to a depth of | ffeet |
| Type of grout (circle one): Cement Bentonite | Mix | |
| Casing length: <u>50</u> feet Casing diameter: <u>4</u> | inches Type of casing | |
| Screen length: <u>20</u> feet Screen diameter: <u>1</u> | inches Type of screen: | PVC |
| Screen slot size:iol 0inches Setting depth: 1 | From <u>50</u> feet to | |
| | | |
| Type of completion (circle all applicable): Gravel packed | | - |
| | : | |
| Top of lap pipe or reduction in casing:fee | | |
| Logs run (circle all applicable): No log run Electric Gamm | | |
| Name of organization running log(s): | ted in accordance with all applical | ble requirements of the Mississippi |
| I certify that the well was drilled, constructed, and comple Department of Environmental Quality and/or the Mississi | nni Department of Health regulati | ons and state laws. |
| 1 | | |
| Rayborn Drilling, Inc. 0-6 | 20 | 2-1/2- |
| Print Name of Water Well Contractor and License No. | Signatur | e of Water Web Contractor |
| L | | RECEIVE |
| | | JUL 2 3 2008 |
| | | BY: OLW |

۲

| 0 | P | ELL REPORT Part 2 | For Office Use Only: | |
|---|----------------------------|--|--|--|
| county: Kankin | Pump Installer' | s Completion Report nt of Environmental Quality | | |
| Permit #: | Office of Land | and Water Resources | Aquifer: | |
| Driller: Gary Rayborn | | Box 10631 MS 39289-0631 | Well #: (3.2 | |
| Date completed: <u>7-2-08</u> | (601 |)961-5210 | Elevation: | |
| | | 4-0938 (lax) | | |
| This report should be prepared by the installation of pump. | | il and filed with the Departm | nent within 30 days of the | |
| Well Owner Informati | ion | V | Well Location | |
| Owner Name: D+D Drillin | g, Inc | <u>C</u> Latitude:Longitude: | | |
| Mailing Address: P.O. Box 16 | 34 | Method of Lat/Long (circle | e one): Conventional Survey, | |
| | | | and-held GPS, Survey-grade GPS | |
| Ferriday LA 71334 City State Zip Code | | 1414 Sec_ | 23 Twn 4N Rng 3E | |
| City O State | Zip Code | Distance Direction | n Nearest Town | |
| Telephone No. (318) 757- 327 | νų. | | of Brandon | |
| Telephone No. $(9,0)$ 191 92 . | | | | |
| Ритр Туре | | | Power Type | |
| Circle one | | | Circle one | |
| Air Lift Jet (| Submersible | Diesel Engine Gas | soline Engine Natural Gas | |
| Bucket Piston | Turbine | Electric Motor Ha | nd Tractor PTO | |
| Centrifugal Rotary | Flowing Well | | her (specify): | |
| Other (specify): | | Horse Power Rating of M | otor: <u>1-HP</u> | |
| Date Pump Installed: 7-10-0 | 8 | Setting Depth: | <u>p ()</u> feet | |
| 12 | Gallons Per Minute | Number of Stages: | 14 | |
| Rated Pump Capacity: | | | ······································ | |
| Pump Test Data | | Method of Measuring Water Level | | |
| Date Well Tested:7-10-08 | | | Circle one | |
| | | Air Line Electric | Measuring Line Steel Tape | |
| Static Water Level (A):Fee | t Below Land Surface | Other (specify): | | |
| Pumping Water Level (B):Feet | t Below Land Surface | | | |
| Drawdown [(B) – (A)]:Fee | et Below Land Surface | | ed shut in head:fee | |
| Test Pumping Rate: 10 | | Well yielded GPM with a drawdown of | | |
| Duration of Pump Test (minimum 4 hours |):hours | feet af | terhours of pumpir | |
| | | | | |
| I HEREBY CERTIFY that the above state | ements are true to the bes | st of my knowledge. | ~~~~ | |
| Gary Rayborn | · | | | |
| Print Name of Pump Installer and License | No. (if applicable) | Signature of Pur | RECEIVE | |

JUL 2 3 2008 BY: OLWR If well telescopes please sketch below and show depths.

Ground Level


 $\sim r^{2}$

۰,

632

| Description of Formations Encountered | From | To |
|---------------------------------------|------|----|
| Clay | 0 | 13 |
| Pea Gravel | 13 | 16 |
| Clay | 16 | 58 |
| Sand | 58 | 68 |
| Clay | 68 | 70 |
| | | |
| | | |
| | | _ |

If more than one screen, show location of each on sketch

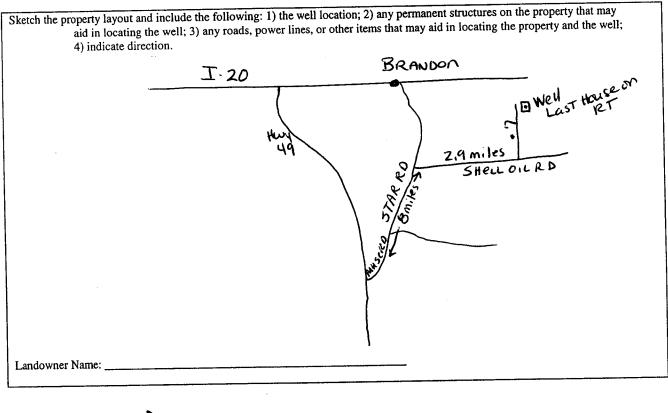

Signature of Water Well Contractor

JUL 2 3 2008 BY: OLWR