

Rankin
R 15
9-67
E-109

MISSISSIPPI BOARD OF WATER COMMISSIONERS
416 North State Street
Jackson, Mississippi 39201
CODED MS
R2

WATER WELL DRILLERS LOG

9-25 1967 date well completed
Water Well Ser. Co. firm name
Rankin county well located

LANDOWNER: W.H. Worley
Rt 2, Brandon

description of formations encountered	from	to
gravel + sand	0	60

(mailing address)

WELL LOCATION: NE, NE
sec. 20 T 4 N R 4 E
S W
7 miles S of Brandon
(distance) (direction) (nearest town)

WELL PURPOSE: Home
(home, irrigation, municipal, industrial)

WELL COMPLETION DATA:

- (1) diameter (inches) 2"
- (2) total depth (feet) 100'
- (3) static water level (feet) 20 ^{below} top of ground.
- (4) casing (material) (depth)
if telescope see back.
(size) ✓
- (5) screen (length) (depth to top)
2" 55'
(size) (material) S.S.
- (6) pump (HP) (yield gpm)
3/4 10
- (type power) Elec.
- (7) electric log (yes or no) Yes
(organization running log) Miss. Sw. Sur.

(8) how well bottom plugged


DRILLERS REMARKS:

CODED

JUL - 8 1968
MISS. BOARD OF
WATER COMMISSIONERS

If well telescopes please sketch and show depths.

GROUND LEVEL

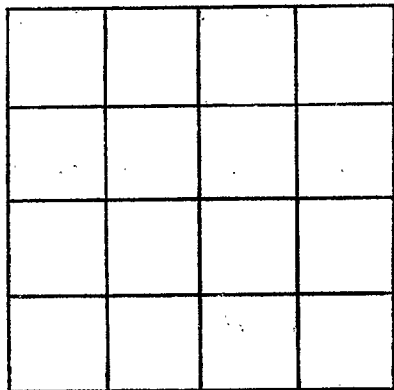

SECTION _____

Please indicate well location X.

ADDITIONAL INFORMATION

If more than one screen, show locations of each on sketch.