


R18
4-17-63

WATER WELL DRILLERS LOG

Date: April 17, 1963, Driller: W. G. Butler County: Smith
(Name)

(1) Owner of Land:	Description & Color of Materials Sand, Clay, Red Clay, Shell, etc.	Thick- ness Feet	Depth Feet
<u>A. K. COX</u> (Name) <u>Brandon, Miss. Rt 1</u> (Address)	Clay	7	10
(2) Location: $\frac{1}{4}$, $\frac{1}{4}$, Sec. <u>19 N 4 E</u>	Clay	10	15
(distance) _____ miles _____ of _____ (direction) (Nearest Town)	Sand + chalk	15	35
(3) Topography: _____ (Hilly) (Flat) (Level) #	Rock + chalk	35	40
(4) Purpose of Well: _____ (Domestic Irrigation) (Municipal, Industrial, Other)	Sand + chalk	40	45
Information upon completion of well:	Blue chalk + rock	45	60
(1) Diameter <u>2"</u> inches.	Sand + chalk	60	70
(2) Total Depth <u>232</u> feet.	chalk	70	70
(3) Water Level _____ feet below top of ground.	Chalk + Rock	90	100
(4) Cased to _____ Size <u>2"</u>	Chalk	100	110
(5) Screen: Size <u>2"</u> , Length <u>15'</u>	Shell + chalk	110	120
(6) Were any formations sealed against pollution?	Shell + sand	120	125
_____ yes, _____ no.	Rock	125	130
If YES depth of formation _____	Shell	130	135
Why _____	Rock	135	150
Drillers Remarks: _____	Shell, Rock + sand	150	160
	Shell + sand	160	180
	Fine sand	180	190
	Sand	190	200
	Lignite + sand	200	210
	Chalk	210	232

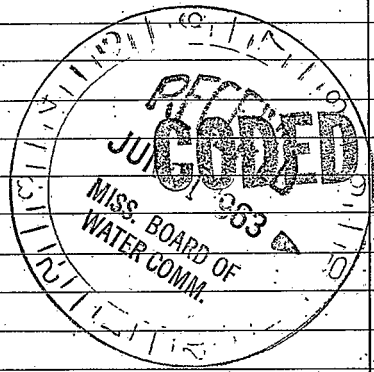

(Use Back Side)

Well No.

