

RANKIN MISSISSIPPI BOARD OF WATER COMMISSIONERS

R 20
4-24-64

WATER WELL DRILLERS LOG **CODED**

Date: April 24 1964, Driller: W. G. Butler County Smith
(Name)

(1) Owner of Land: F. C. Butler
(Name)

Brandon, Miss.
(Address)

(2) Location: 1/4, 1/4, Sec. 4 T4R4,
N E

5 miles West of Johns,
(distance) (direction) (Nearest Town)

(3) Topography: (Hilly) (Flat) (Level)

(4) Purpose of Well: Domestic
(Domestic Irrigation, Municipal, Industrial, Other)

Description & Color of Materials Sand, Clay, Red Clay, Shell, etc.	Thick- ness Feet	Depth Feet
Red clay	1-5	5
Chalk + sand	5-20	20
Chalk	20-30	30
Rock + chalk	30-50	50
Chalk + lignite	50-60	60
Chalk	60-110	110
Rock	110-120	120
Rock + chalk	140-150	150
Rock + shell	150-160	160
Shell + sand	160-165	165
Sand	165-170	170
Shell + sand	170-180	180
Sand + lignite	180-190	190
Chalk	190-211	211

Information upon completion of well:

(1) Diameter 2 inches.

(2) Total Depth 211 feet.

(3) Water Level _____ feet below top of ground.

(4) Cased to 177', Size 2"

(5) Screen: Size 2", Length 10'


(6) Were any formations sealed against pollution?
_____ yes, _____ no.

If YES depth of formation _____

Why _____

Drillers Remarks: _____

CODED

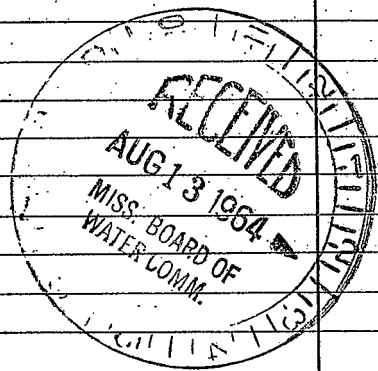

(Use Back Side)

Well No.

[The page contains extremely faint and illegible text, likely bleed-through from the reverse side. The text is too light to transcribe accurately.]