

Rankin
R 24
4-67

MISSISSIPPI
BOARD OF WATER CONTROL
416 North State Street
Jackson, Mississippi 39201

CODED

WATER WELL DRILLERS LOG

Apr 16 - 1967 W. G. Butler Rankin
date well completed firm name county well located

LANDOWNER:
H. M. N. Pire
Rt. 2. Brandon
(mailing address)

WELL LOCATION:
sec 35 T 4 N R 4 E
1 1/2 miles W of Johns
(distance) (direction) (nearest town)

description of formations encountered	from	to
	<u>Chalk + clay</u>	<u>1-</u>
<u>Chalk + sand</u>	<u>10-</u>	<u>20</u>
<u>Chalk</u>	<u>20-</u>	<u>25</u>
<u>Chalk + sand</u>	<u>25-</u>	<u>40</u>
<u>Sand</u>	<u>40-</u>	<u>50</u>
<u>Sand + Chalk</u>	<u>50-</u>	<u>60</u>
<u>Sand</u>	<u>60-</u>	<u>90</u>

WELL PURPOSE: Home
(home, irrigation, municipal, industrial)

WELL COMPLETION DATA:

(1) diameter (inches) 2"

(2) total depth (feet) 90'

(3) static water level (feet) 17 ^{below} above top of ground.

(4) casing galv. 73
(material) (depth)
2" if telescope see back,
(size)

(5) screen 5' 73
(length) (depth to top)
2" st. steel.
(size) (material)

(6) pump 1/4 10
(HP) (yield gpm)
Electric
(type power)

(7) electric log NO
(yes or no)
(organization running log)

(8) how well bottom plugged 2" Back
wash valve


CODED



DRILLERS REMARKS:

If well telescopes please sketch and show depths.

GROUND LEVEL

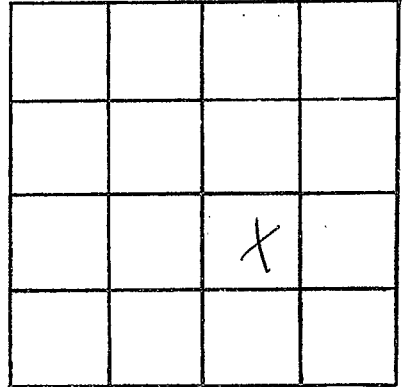

SECTION 35

Please indicate well location X.

ADDITIONAL INFORMATION

If more than one screen,
show locations of each on sketch.