

Returned 6/20/69
Perk. book 6/26/69

MISSISSIPPI
BOARD OF WATER COMMISSIONERS
416 North State Street
Jackson, Mississippi 39201

WATER WELL DRILLERS LOG **CODED**

Rankin
R26
4-15-69

4-15-1969 69 Water well Sec Co. Rankin
date well completed firm name county well located

LANDOWNER:

Billy R Ponder

description of formations encountered

from to

Rt 2 Brandon Miss
(mailing address)

Clay
Sand

0 330
330 357

WELL LOCATION:

sec. 28 T 4 N R 4 E
S W
10 miles S of Brandon
(distance) (direction) (nearest town)

WELL PURPOSE:

HOME
(home, irrigation, municipal, industrial)

WELL COMPLETION DATA:

- (1) diameter (inches) 2"
- (2) total depth (feet) 357
- (3) static water level (feet) 84 below top of ground.
- (4) casing (material) (depth) 0 - Not cased
- (size) if telescope see back. no screens
- (5) screen (length) (depth to top) 0
- (size) (material)
- (6) pump (HP) (yield gpm) 30 ?
(type power) Elec
- (7) electric log (yes or no) yes
MBS
(organization running log)
- (8) how well bottom plugged OPEN

CODED


JUN 20 1969

MISS. BD. OF
WATER COMMISSIONERS

DRILLERS REMARKS:

If well telescopes please sketch and show depths.

GROUND LEVEL

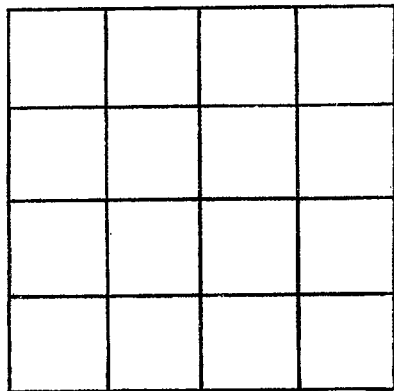

SECTION _____

Please indicate well location X.

ADDITIONAL INFORMATION

If more than one screen, show locations of each on sketch.