

**MISSISSIPPI
BOARD OF WATER COMMISSIONERS**
416 North State Street
Jackson, Mississippi 39201

CODED

WATER WELL DRILLERS LOG

Rankin
R27
5-27-69
M. G. S.

5-27 1969 M. E. Thompson Rankin
date well completed firm name county well located

LANDOWNER:
O. E. Bunker

(mailing address)

description of formations encountered	from	to
<u>Fill</u>	<u>0</u>	<u>20</u>
<u>Clay</u>	<u>20</u>	<u>60</u>
<u>Sand</u>	<u>60</u>	<u>120</u>
<u>Brown clay</u>	<u>120</u>	<u>120</u>

WELL LOCATION:
sec. 35 T. 4 N R. 4 E
2 miles NW of Graham
(distance) (direction) (nearest town)

WELL PURPOSE:
(home, irrigation, municipal, industrial)

WELL COMPLETION DATA:

(1) diameter (inches) 2"

(2) total depth (feet) 124"

(3) static water level (feet) 60 below above top of ground.

(4) casing Gal 115'
(material) (depth)
9" If telescope see back.
(size)

(5) screen 5" 115'
(length) (depth to top)
2" S.S.
(size) (material)

(6) pump 3/4 7
(HP) (yield gpm)
Electric
(type power)

(7) electric log yes
(yes or no)
M. G. S.
(organization running log)

(8) how well bottom plugged Blow hole


JUN 2 - 1969

**MISS. BD. OF
WATER COM.**

DRILLERS REMARKS:

If well telescopes please sketch and show depths.

GROUND LEVEL

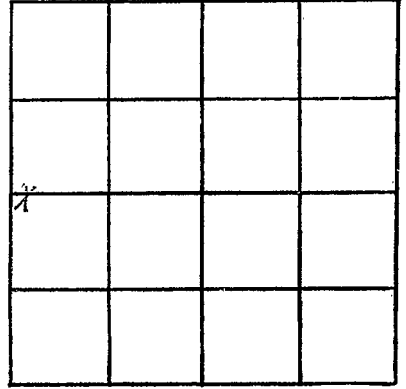

SECTION 35

Please indicate well location X.

ADDITIONAL INFORMATION

If more than one screen,
show locations of each on sketch.