

Rankin
R 28
11-23-69
M65

MISSISSIPPI
 BOARD OF WATER COMMISSIONERS
 416 North State Street
 Jackson, Mississippi 39201

CODED

WATER WELL DRILLERS LOG

Nov. 23 1969 W.L. Thompson Well Dr. Rankin
 date well completed firm name county well located

LANDOWNER:	description of formations encountered	from	to
<u>Mims Williams</u>			
<u>Rock Hill community</u> (mailing address)	<u>clay</u>	<u>0</u>	<u>20</u>
	<u>Blue clay</u>	<u>20</u>	<u>70</u>
WELL LOCATION:	<u>sand</u>	<u>70</u>	<u>104</u>
sec. <u>27</u> T. <u>4</u> N. <u>5</u> R. <u>4</u> E. <u>11</u>	<u>Blue clay</u>	<u>104</u>	<u>150</u>
_____ miles _____ of _____ (distance) (direction) (nearest town)	<u>Bayou clay & shell</u>	<u>150</u>	<u>189</u>
WELL PURPOSE: (home, irrigation, municipal, industrial)			

WELL COMPLETION DATA:

(1) diameter (inches) 2"

(2) total depth (feet) 189

(3) static water level (feet) 25 below above top of ground.

(4) casing Alastic 90'
(material) (depth)
2"
(size) if telescope see back.

(5) screen 10' 90
(length) (depth to top)
2" Alastic
(size) (material)

(6) pump air 30
(HP) (yield gpm)
air
(type power)

(7) electric log yes
(yes or no)
M.S.S.
(organization running log)

(8) how well bottom plugged B/W. Lake

CODED


DEC - 2 1969

DRILLERS REMARKS: Recess
this was a well that a shot
hole driller said could be
made at 200 feet.

MISS. BD. OF
 WATER COMMISSIONERS

If well telescopes please sketch and show depths.

GROUND LEVEL

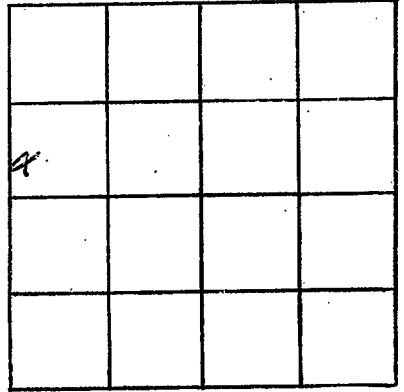

SECTION 27

Please indicate well location X.

ADDITIONAL INFORMATION

If more than one screen,
show locations of each on sketch.