

ELOG # 259

MISSISSIPPI BOARD OF WATER COMMISSIONERS
416 North State Street
Jackson, Mississippi 39201

CODED

WATER WELL DRILLERS LOG

Rankin
R 30
5-15-70

5/15 date well completed 70 R.E. Thompson firm name Rankin county well located

LANDOWNER:	description of formations encountered	from	to
W. H. Crawford Brookhaven Miss. (mailing address)			
WELL LOCATION:	Below clay	18'	55'
sec. 21 T 4 N R 4 E 4 1/4 miles N/W of John's (distance) (direction) (nearest town)	Sand	18.5'	72'
WELL PURPOSE: <u>Outback Sprinkler</u> (home, irrigation, municipal, industrial)			
WELL COMPLETION DATA:			
(1) diameter (inches) <u>2"</u>			
(2) total depth (feet) <u>72'</u>			
(3) static water level (feet) <u>32'</u> below above top of ground.			
(4) casing <u>Plastic 62'</u> (material) (depth), <u>2"</u> (size) if telescope see back.			
(5) screen <u>10'</u> , <u>62'</u> (length) (depth to top) <u>2"</u> , <u>Plastic</u> (size) (material)			
(6) pump <u>15</u> (HP) (yield gpm) <u>air</u> (type power)			
(7) electric log <u>yes</u> (yes or no) <u>M&S</u> (organization running log)			
(8) how well bottom plugged <u>3/4 water</u>			

JUL 1 1970


MISS. BD. OF WATER COMM.

DRILLERS REMARKS:

Well did not do so good to W.H. Crawford soil

If well telescopes please sketch and show depths.

GROUND LEVEL

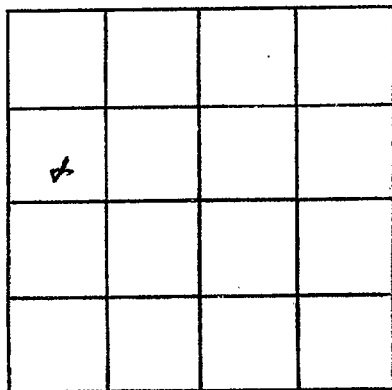

SECTION 21

Please indicate well location X.

ADDITIONAL INFORMATION

If more than one screen, show locations of each on sketch.