

Rtn 7/28/69

MISSISSIPPI
BOARD OF WATER COMMISSIONERS
416 North State Street
Jackson, Mississippi 39201

OK 8/11/69

CODED

WATER WELL DRILLERS LOG

7/9 1969 Forest Drilling Rankin
date well completed firm name county well located

LANDOWNER:

Mr. J. A. Mason
Brandon, Miss.
(mailing address)

description of formations encountered

from

to

Clay	0	20
Red sand	20	25
Blue clay	25	40
Clay + sh. fine sand	40	66
Clay	66	112
Rock + sh. clay	112	153
Hardy shale	153	175
Fine sand + sh. clay	175	184
Shale	184	200
Soft shale	200	245
Soft shale + sh. fine sand	245	281
Fine sand	281	292
Shale	292	337

WELL LOCATION:

sec. 6 T 4 N R 4 E S 37
4 miles SE Brandon
(distance) (direction) (nearest town)

WELL PURPOSE:

home
(home, irrigation, municipal, industrial)

WELL COMPLETION DATA:

- (1) diameter (inches) 2"
- (2) total depth (feet) 304'
- (3) static water level (feet) 178' below top of ground.
- (4) casing 2 1/2" Galv (material), 294' (depth)
2" (size) if telescope see back.
- (5) screen 10' (length), 294' (depth to top)
2" (size), stainless steel (material)
- (6) pump 2 (HP), 10 (yield gpm)
Electric (type power)
- (7) electric log NO (yes or no)

CODED

(organization running log)

(8) how well bottom plugged 2"
Backwash valve


JUL 29 1969

DRILLERS REMARKS:

MISS. BD. OF
WATER COMM.

If well telescopes please sketch and show depths.

GROUND LEVEL

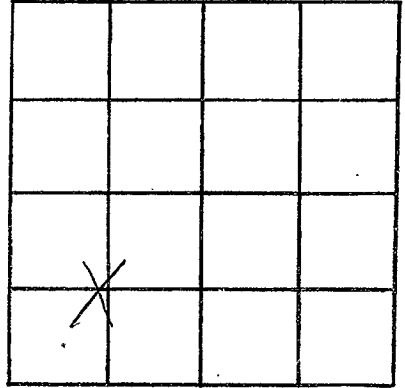

SECTION 6

Please indicate well location X.

ADDITIONAL INFORMATION

If more than one screen, show locations of each on sketch.