

RANKIN

R 37

1-14-74

MISSISSIPPI
 BOARD OF WATER COMMISSIONERS
 416 North State Street
 Jackson, Mississippi 39201

WATER WELL DRILLERS LOG

CODED

Jan. 14 - 1974
date well completed

W. G. Butler
firm name

Rankin
county well located

LANDOWNER:

Roy Shoemaker
Rt. 2 - Brandon
(mailing address)

description of formations encountered

from to

Rock	0 - 90
Clay	90 - 150
Clay	150 - 228
Sand	228 - 240

WELL LOCATION:

sec. 22 T. 4 N R. 10 E
S
2 1/2 miles east of Johns
(distance) (direction) (nearest town)

WELL PURPOSE:

Home
(home, irrigation, municipal, industrial)

WELL COMPLETION DATA:

- (1) diameter (inches) 2"
- (2) total depth (feet) 240
- (3) static water level (feet) 55' below top of ground.
- (4) casing galv., 170' (material), (depth)
2" (size) If telescope see back.
- (5) screen open, hole well (length) (depth to top)
(size) (material)
- (6) pump 3/4 (HP) 4 1/2 (yield gpm)
Electric (type power)
- (7) electric log No (yes or no)
(organization running log)
- (8) how well bottom plugged

CODED


RECEIVED
FEB 14 1974

MISS. BD. OF WATER COMM

DRILLERS REMARKS:

If well telescopes please sketch and show depths.

GROUND LEVEL

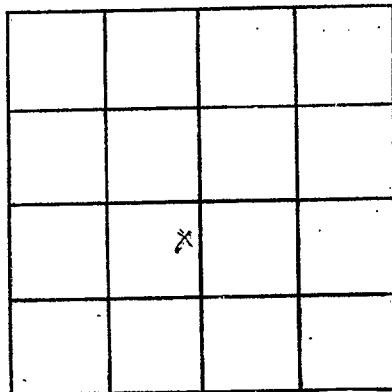

SECTION 22

Please indicate well location X.

ADDITIONAL INFORMATION

If more than one screen, show locations of each on sketch.