

RANKIN
R 38
11/25/74

MISSISSIPPI
 BOARD OF WATER COMMISSIONERS
 416 North State Street
 Jackson, Mississippi 39201

CODED

WATER WELL DRILLERS LOG

11/25 1974 Forest Drilling, Inc. Rankin
 date well completed firm name county well located

LANDOWNER:
Bob Meyings
Jackson, Miss
 (mailing address)

WELL LOCATION:
 sec. 3 T. 4 N R. 4 E
7 miles SE of Brandon
 (distance) (direction) (nearest town)

WELL PURPOSE:
 (home, irrigation, municipal, industrial)

WELL COMPLETION DATA:

- (1) diameter (inches) 4x2 **CODED**
- (2) total depth (feet) 720
- (3) static water level (feet) 235 below top of ground.
- (4) casing Galv. 720
 (material) (depth)
- (size) if telescope see back.
- (5) screen 15 705
 (length) (depth to top)
2" 1/2" steel
 (size) (material)
- (6) pump 3 20
 (HP) (yield gpm)
220V
 (type power)
- (7) electric log no
 (yes or no)
 (organization running log)
- (8) how well bottom plugged 2"
1/2" mesh valve

description of formations encountered	from	to
Clay	0	61
Rock & Clay	61	116
Soft sand	116	132
Clay	132	178
Soft sand	178	262
Clay	262	430
Shale	430	531
Shale & Rock	531	604
Sandy shell	604	611
Shale & Rock	611	631
Shale & Fine Sand	631	657
Sand & Shell	657	720


MISS. DD OF WATER COMMISSIONERS
DEC 2 1974

DRILLERS REMARKS:

If well telescopes please sketch and show depths.

GROUND LEVEL

317' - 7"
705' - 2"

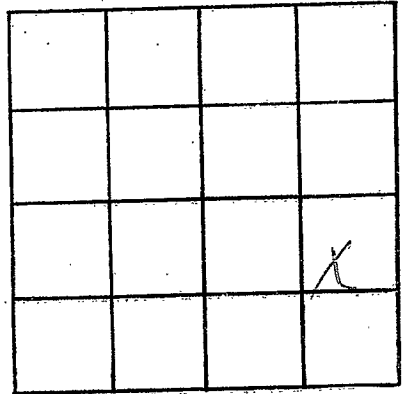

SECTION 3

Please indicate well location X.

ADDITIONAL INFORMATION

If more than one screen,
show locations of each on sketch.