

RANKIN
R39
4/23/80

MISSISSIPPI
 BOARD OF WATER COMMISSION **CODED**
 416 North State Street
 Jackson, Mississippi 39201

WATER WELL DRILLERS LOG

6-23 19 80 Gerron Well Dr Rankin
 date well completed firm name county well located

LANDOWNER:
Ed Naman
 (mailing address)

description of formations encountered	from	to
<u>CLAY</u>	<u>0</u>	<u>110</u>
<u>SAND</u>	<u>110</u>	<u>170</u>

WELL LOCATION:
 sec. 1 T 4 N R 4 E
 S W
 _____ miles _____ of _____
 (distance) (direction) (nearest town)

CODED

WELL PURPOSE:
 (home, irrigation, municipal, industrial)

WELL COMPLETION DATA:

- (1) diameter (inches) 2"
- (2) total depth (feet) 170
- (3) static water level (feet) 30 below above top of ground.
- (4) casing PVC, 150
 (material) (depth)
2"
 (size) if telescope see back.
- (5) screen 20, 150
 (length) (depth to top)
2, PVC
 (size) (material)
- (6) pump 1, 40
 (HP) (yield gpm)

(type power)

(7) electric log _____
 (yes-or-no)
NO
 (organization running log)

(8) how well bottom plugged 130V

DRILLERS REMARKS:


DEPT. OF NATURAL RESOURCES
 BUREAU OF LAND & WATER RESOURCES

NOV 12 1980

RECEIVED

If well telescopes please sketch and show depths.

GROUND LEVEL

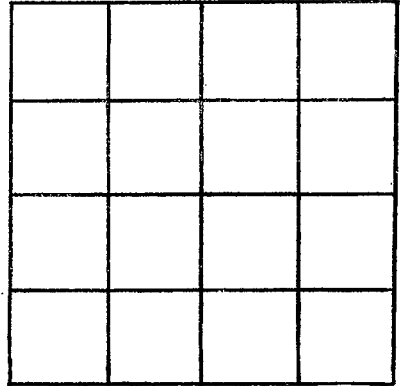

SECTION _____

Please indicate well location X.

ADDITIONAL INFORMATION

If more than one screen, show locations of each on sketch.