

RANKIN  
 R40  
 2-17-82

MISSISSIPPI  
 BOARD OF WATER COMMISSIONERS  
 416 North State Street  
 Jackson, Mississippi 39201

CODED

WATER WELL DRILLERS LOG

2-17-1982 date well completed  
 Guinn wellson RANKIN firm name  
 county well located

LANDOWNER:  
 Larry Zilliger  
 (mailing address)

description of formations encountered	from	to
SAND	0	30
CLAY	30	110
Rock	110	120
SAND	120	150

WELL LOCATION:  
 sec. 2 T 4N R 4E  
 S W  
 (distance) miles (direction) of (nearest town)

WELL PURPOSE:  
 (home, irrigation, municipal, industrial)

- WELL COMPLETION DATA:
- (1) diameter (inches) 4"
  - (2) total depth (feet) 150
  - (3) static water level (feet) 90 below top of ground.
  - (4) casing PVC 130 (material) (depth)  
 4" if telescope see back. (size)
  - (5) screen 20 130 (length) (depth to top)  
 4" PVC (size) (material)
  - (6) pump 1 4 (HP) (yield gpm)  
 (type power)
  - (7) electric log (yes or no)  
 (organization running log)
  - (8) how well bottom plugged B&V

CODE

DEPT. OF NATURAL RESOURCES  
 BUREAU OF LAND & WATER RESOURCES


NOV 30 1982

RECEIVED

DRILLERS REMARKS:

If well telescopes please sketch and show depths.

GROUND LEVEL

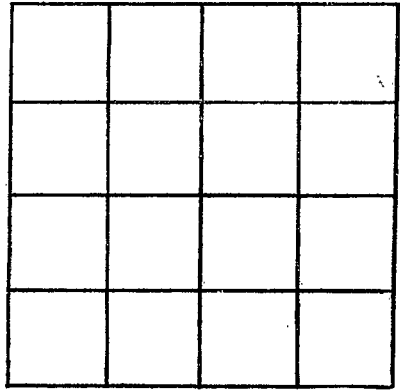

SECTION \_\_\_\_\_

Please indicate well location X.

ADDITIONAL INFORMATION

If more than one screen, show locations of each on sketch.