

RANKIN
R 44
1-19-86

MISSISSIPPI DEPARTMENT OF NATURAL RESOURCES
 Bureau of Land and Water Resources
 Southport Mall
 P.O. Box 10631
 Jackson, Mississippi 39209 **CODED**
WATER WELL DRILLERS LOG

7/19 1986 Jerry/Guinn Waterwell Serv Rankin
 date well completed firm name county well located

LANDOWNER: Judy Jenkins
Shidoh Rd
Brandon, Ms
 (mailing address)
 WELL LOCATION:
 sec. 2 T 4 N R 4 E
12 miles SE of BRANDON
 (distance) (direction) (nearest town)

description of formations encountered	from	to
Sand	0	110
Clay + shale	110	224
Sand	224	244
Clay	244	270

WELL PURPOSE: Home
 (home, irrigation, municipal, industrial)

WELL COMPLETION DATA:
 (1) diameter (inches) 4"
 (2) total depth (feet) 270'
 (3) static water level (feet) 150 below top of ground.
 (4) casing PVC, 230'
 (material) (depth)
4" if telescope see back.
 (size)
 (5) screen 10, 230
 (length) (depth to top)
4", PVC
 (size) (material)
 (6) pump 1/2 10
 (HP) (yield gpm)
electricity
 (type power)
 (7) electric log Yes
 (yes or no)
Ms. Bureau of Geology
 (organization running log)
 (8) how well bottom plugged Backwash Valve

CODED

DISCLAIMER


SEP 30 1986

Department of Natural Resources
 Bureau of Land & Water Resources

DRILLERS REMARKS:

If well telescopes please sketch and show depths.

GROUND LEVEL

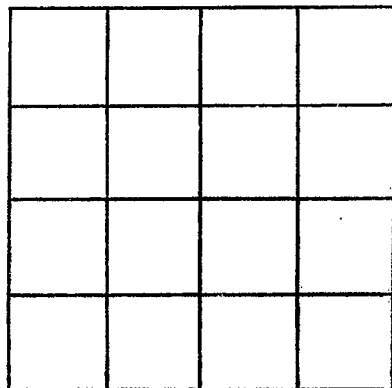

SECTION _____

Please indicate well location X.

ADDITIONAL INFORMATION

If more than one screen,
show locations of each on sketch.