

RANKIN
R 45
7-25-87

MISSISSIPPI DEPARTMENT OF NATURAL RESOURCES
 Bureau of Land and Water Resources
 Southport Mall
 P.O. Box 10631
 Jackson, Mississippi 39209
WATER WELL DRILLERS LOG

Coded

7-25-87 19 HERNDON WELL + SUPPLY INC RANKIN
 date well completed firm name county well located

LANDOWNER: BUCKHORN HUNTING CLUB
 (mailing address)

WELL LOCATION:
 sec 16 T. 4 (N) R. 4 (E)
 NW, NE S W
9.5 miles SOUTH of BRANDON
 (distance) (direction) (nearest town)

WELL PURPOSE: CAMP HOUSE
 (home) irrigation, municipal, industrial)

- WELL COMPLETION DATA:
- (1) diameter (inches) 4 x 2
 - (2) total depth (feet) 125'
 - (3) static water level (feet) 62.2 below top of ground.
 - (4) casing PVC, 0-115,
 (material) (depth)
4 x 2 if telescope see back.
 (size)
 - (5) screen 10', 115
 (length) (depth to top)
2", STAINLESS STEEL
 (size) (material)
 - (6) pump 1/3, 5 gpm
 (HP) (yield gpm)
ELECTRIC
 (type power)
 - (7) electric log YES
 (yes or no)
HERNDON WELL + SUPPLY
 (organization running log)
 - (8) how well bottom plugged BACKWASH VALVE

description of formations encountered	from	to
RED CLAY SANDY	0	36
SHALE ROCK	36	38
GRAY CLAY	38	92
SANDY CLAY	92	110
SAND	110	125
GRAY CLAY	125	
TOTAL DEPTH DRILLED	135	

RECEIVED


AUG 17 1987

Department of Natural Resources
 Bureau of Land & Water Resources

DRILLERS REMARKS: ELECTRIC LOG
SENT TO U.S.G.S AND BILL
OAKLEY
M. HERNDON

If well telescopes please sketch and show depths.

GROUND LEVEL

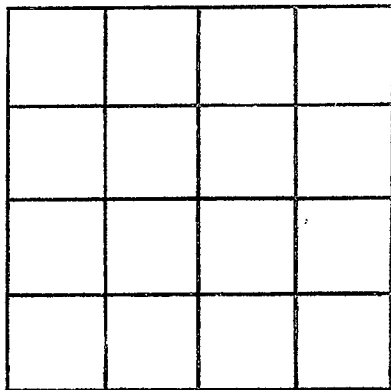

SECTION _____

Please indicate well location X.

ADDITIONAL INFORMATION

If more than one screen,
show locations of each on sketch.