

CODED

Mo 54

Rankin
520
3-68
E-109

MISSISSIPPI
BOARD OF WATER COMMISSIONERS
416 North State Street
Jackson, Mississippi 39201

WATER WELL DRILLERS LOG

3-26 1968 date well completed Water Well Serv Co. firm name Rankin county well located

LANDOWNER: Billy Means
Rt 2, Brandon, Miss

description of formations encountered	from	to
	Blue clay	0
Sand + clay	300	560
Fine sand	560	570
Blue clay	570	588
Sand	588	612
Blue clay	612	620
Fine sand	620	630
Blue clay	630	642
Coarse sand	642	759

(mailing address)

WELL LOCATION: NW, SE
sec 25 T 4 N R 5 E
S W
7 miles S of Belahatchee
(distance) (direction) (nearest town)

WELL PURPOSE: Home
(home, irrigation, municipal, industrial)

WELL COMPLETION DATA:

- (1) diameter (inches) 4 1/2
- (2) total depth (feet) 759
- (3) static water level (feet) 100 below top of ground.
- (4) casing C.I. 150
(material) (depth)
4" If telescope see back.
(size)
- (5) screen 10' 740
(length) (depth to top)
2" S.S.
(size) (material)
- (6) pump 1 15
(HP) (yield gpm)
Electric
(type power)
- (7) electric log yes
(yes or no)
Miss. Geo. Surv.
(organization running log)
- (8) how well bottom plugged _____

CODED


JUL - 8 1968

MISS. BOARD OF
WATER COMM.

DRILLERS REMARKS:

If well telescopes please sketch and show depths.

GROUND LEVEL

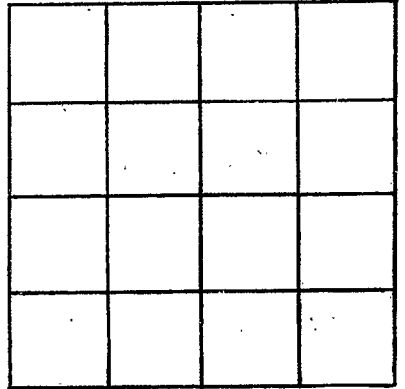

SECTION _____

Please indicate well location X.

ADDITIONAL INFORMATION

If more than one screen, show locations of each on sketch.