

RANKIN MISSISSIPPI BOARD OF WATER COMMISSIONERS

~~W-521~~ S 21
5-25-63

WATER WELL DRILLERS LOG

Date: May 25 63, 1963, Driller: W. B. B... County: Smith

CODED

(1) Owner of Land: D. K. Patrick
 (Name) Brandon, Miss.
 (Address) 36 1/2 N SE
 (2) Location: 1/4, 1/4, Sec. T R
1/4 West Johns
 (distance) (direction) (Nearest Town)
 (3) Topography: Domestic
 (Hilly) (Flat) (Level)
 (4) Purpose of Well: Domestic
 (Domestic Irrigation, Municipal, Industrial, Other)


Description & Color of Materials Sand, Clay, Red Clay, Shell, etc.	Thick-ness Feet	Depth (Feet)
Chalk	5-10	
Sand	10-15	
Chalk	18-26	
Rock + Blue chalk	20-40	
Sand + Blue chalk	40-60	
Sand, Rock + chalk	60-70	
Sand + chalk	70-100	

Information upon completion of well:

(1) Diameter 2 inches.
100
 (2) Total Depth 25 feet.
 (3) Water Level 84' feet below top of ground. 2"
 (4) Cased to 2", Size 5'
 (5) Screen: Size 2", Length 5'
 (6) Were any formations sealed against pollution?
yes, no.

CODED

If YES depth of formation _____
 Why _____
 Drillers Remarks: _____

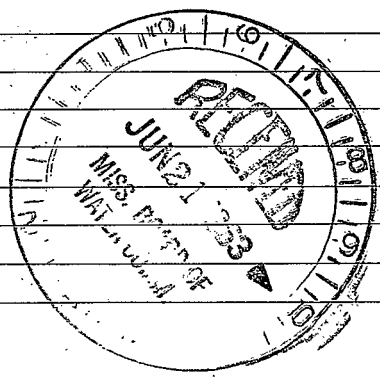

(Use Back Side)

Well No.

1907

1907