

RANKIN
S 33
7-4-79

MISSISSIPPI
BOARD OF WATER COMMISSIONERS
416 North State Street
Jackson, Mississippi 39201

CODED

WATER WELL DRILLERS LOG

7-4 1979 Griner Drilling Rankin
date well completed firm name county well located

LANDOWNER:
Systems Fuel
P.O. Drawer 798
Drentiss, MS 39474
(mailing address)

description of formations encountered	from	to
clay	0	483
sand, shell, clay	483	546
sand	546	613

WELL LOCATION: 500' S + 1450' E of
sec. 14 T. 40 N R. 5 E NW/4
Puckett
(distance) (direction) (nearest town)

WELL PURPOSE: oil field supply
(home, irrigation, municipal, industrial)

- WELL COMPLETION DATA:
- (1) diameter (inches) 3"
 - (2) total depth (feet) 613'
 - (3) static water level (feet) 150' below top of ground.
 - (4) casing steel, 610' (material) (depth)
3" (size) if telescope see back.
 - (5) screen 42' 568' (length) (depth to top)
3' perforated (size) (material)
 - (6) pump — 65 (HP) (yield gpm)
AC (type power)
 - (7) electric log — (yes or no)
(organization running log)
 - (8) how well bottom plugged orange peel

CODED

Miss. Board of Water Comm.


AUG 20 1979

DRILLERS REMARKS:

RECEIVED

If well telescopes please sketch and show depths.

GROUND LEVEL

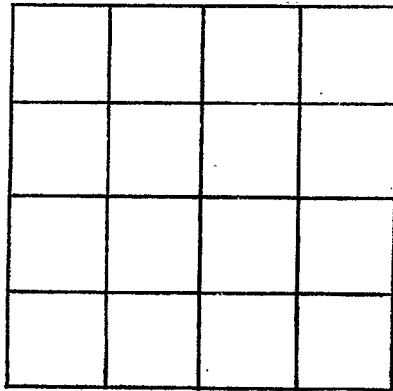

SECTION _____

Please indicate well location X.

ADDITIONAL INFORMATION

A series of horizontal lines for recording additional information, starting below the 'ADDITIONAL INFORMATION' header and extending to the bottom of the page.

If more than one screen, show locations of each on sketch.