

MISSISSIPPI DEPARTMENT OF NATURAL RESOURCES

Bureau of Land and Water Resources

Southport Mall

P.O. Box 10631

Jackson, Mississippi 39209

WATER WELL DRILLERS LOG

CODED

CODED

Rankin
S 34
7-1-81

Greener Drilling Service, Inc.

Rankin

7-1-81 date well completed

firm name

county well located

LANDOWNER:
Tomlinson Interest
2201 Hardy Street
Hattiesburg, MS 39401
(mailing address)


description of formations encountered	from	to
clay, rock, shell	0	660
sand with shell	660	707
clay	707	725
sand	725	817
clay + sand	817	833

WELL LOCATION: 1500N + 1500E
sec. 27 T. 4N R. 5E SW/4
13 miles John Fida
(distance) (direction) (nearest town)

WELL PURPOSE: oil field supply
(home, irrigation, municipal supply)

- WELL COMPLETION DATA:
- (1) diameter (inches) 4"
 - (2) total depth (feet) 833'
 - (3) static water level (feet) 175' ^(below) top of ground.
 - (4) casing steel 817' (material) (depth)
4" (size) if telescope see back.
 - (5) screen 40 777' (length) (depth to top)
4 stainless (size) steel (material) 10 slot
 - (6) pump 50 (HP) (yield gpm)
5 H.P. 440 volt (type power) 3 phase pump
 - (7) electric log NO (yes or no)
- (organization running log)
- (8) how well bottom plugged
4" backwash
valve with wood plug


CODED

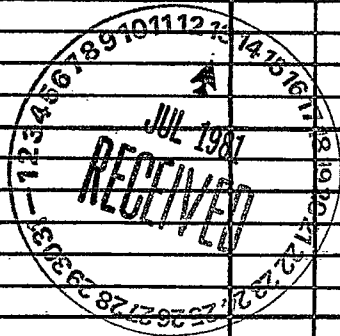

DRILLERS REMARKS:
valve with wood plug

If well telescopes please sketch and show depths.

GROUND LEVEL

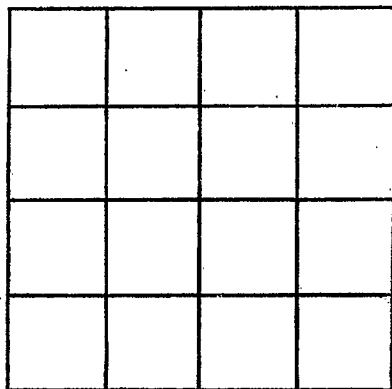

SECTION _____

Please indicate well location X.

ADDITIONAL INFORMATION

If more than one screen,
show locations of each on sketch.