

MISSISSIPPI DEPARTMENT OF NATURAL RESOURCES

Bureau of Land and Water Resources

Southport Mall

P.O. Box 10631

Jackson, Mississippi 39209

WATER WELL DRILLERS LOG

RANKIN
538
9-1-89

Caded

9/1 1989
 date well completed

Jerry Quinn Water Well
 firm name

RANKIN
 county well located

LANDOWNER: John Littich
1132 Hwy 43S.
Brandon, Ms 39042
 (mailing address)

description of formations encountered

from to

WELL LOCATION:
 sec. 20 T. 4 N. R. 5 E.
14 miles S of Pelshatchie
 (distance) (direction) (nearest town)

Clay	0	110
Rock	110	160
Sand	160	170
Shale + Sand	170	200
Sand	200	204
Clay + Sand	204	248

WELL PURPOSE: Home
 (home, irrigation, municipal, industrial)

RECEIVED

WELL COMPLETION DATA:

- (1) diameter (inches) 4
- (2) total depth (feet) 250
- (3) static water level (feet) 80 below top of ground.
- (4) casing PVC, 200 (material), (depth),
4 (size) if telescope see back.
- (5) screen 24, 224 (length), (depth to top)
4, PVC (size), (material)
- (6) pump 1, 10 (HP), (yield gpm)
electricity (type power)
- (7) electric log Yes (yes or no)
Ms Geological Survey (organization running log)
- (8) how well bottom plugged Barbed Valve


APR 11 1990

Department of Natural Resources
 Bureau of Land & Water Resources

DRILLERS REMARKS:

If well telescopes please sketch and show depths.

GROUND LEVEL

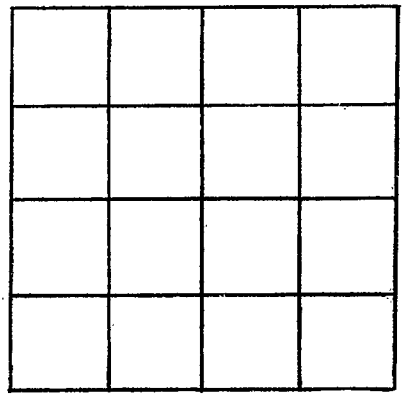

SECTION _____

Please indicate well location X.

ADDITIONAL INFORMATION

A series of horizontal lines for recording additional information, starting below the 'ADDITIONAL INFORMATION' header and extending to the bottom of the page.

If more than one screen, show locations of each on sketch.