

Lease: No. 1 Esther M. Berghaus et al

MISSISSIPPI DEPARTMENT OF NATURAL RESOURCES

Bureau of Land and Water Resources

Southport Mall

P.O. Box 10631

Jackson, Mississippi 39209

WATER WELL DRILLERS LOG

Griner Drilling Service, Inc.

Rankin

12-20-91 date well completed

firm name

county well located

LANDOWNER:

Columbia Gas Development
P.O. Box 1350
Houston, Texas 77251

(mailing address)

WELL LOCATION: 500'S x 500'E

sec. 13 T. 4(N) R. 5(E) of

Puckett NW/4

(distance) (direction) of (nearest town)

WELL PURPOSE: oilfield rig

(home, irrigation, municipal, industrial)


WELL COMPLETION DATA:

- (1) diameter (inches) 3"
- (2) total depth (feet) 700'
- (3) static water level (feet) 240' below top of ground
- (4) casing PVC 620' (material) (depth)
3" (size) if telescope see back.
- (5) screen 60' 620' to 680' (length) (depth to top)
3" PVC Screen (size) (material)
- (6) pump 30 (HP) (yield gpm)
Air Compressor (type power)
- (7) electric log (yes/no)
- (8) how well bottom plugged Back wash valve

description of formations encountered

from to

clay	0	500
streaked sand	500	560
sand	560	580
clay	580	600
sand	600	660
clay	660	700

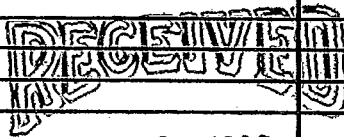


JAN 29 1992

Dept. of Environmental Quality
Bureau of Land & Water Resources

DRILLERS REMARKS:

If well telescopes please
sketch and show depths.

GROUND LEVEL

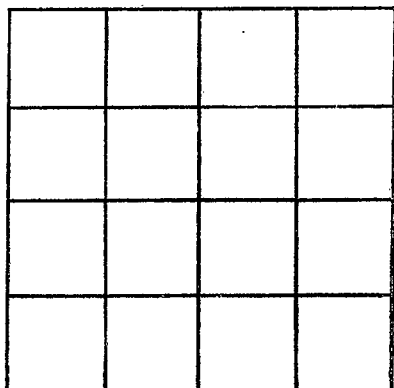

SECTION _____

Please indicate well location X.

ADDITIONAL INFORMATION

If more than one screen,
show locations of each on sketch.