

RANKIN
T11
10-1-60

WATER WELL DRILLERS LOG

CODED

Date: 10/1, 1960, Driller: James A. White County Smith
(Name) Rankin

- (1) Owner of Land: W.N. (Jim) Byrd
(Name)
7 Laurel
(Address)
- (2) Location: NE 1/4, SE 1/4, Sec. 21 T34R1E
6 miles E of Jerry
(distance) (direction) (Nearest Town)
- (3) Topography: X
(Hilly) (Flat) (Level)
- (4) Purpose of Well: Domestic
(Domestic Irrigation
Municipal, Industrial, Other)


Description & Color of Materials Sand, Clay, Red Clay, Shell, etc.	Thick- ness Feet	Depth Feet
<u>red clay</u>	<u>15</u>	<u>15</u>
<u>hard</u>	<u>65</u>	<u>80</u>
<u>water sand</u>	<u>10</u>	<u>90</u>

Information upon completion of well:

- (1) Diameter 2 inches.
- (2) Total Depth 90 feet.
- (3) Water Level 80ft feet below top of ground.
- (4) Cased to 84, Size 2"
- (5) Screen: Size 1/4, Length 6ft
- (6) Were any formations sealed against pollution?
_____ yes, _____ no.

CODED

If YES depth of formation _____
Why _____
Drillers Remarks: _____

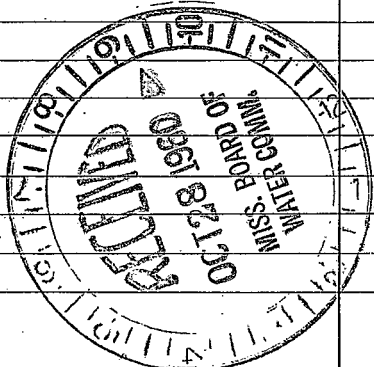

(Use Back Side)

Well No.

