

RANKIN

T 12
10-20-60

WATER WELL DRILLERS LOG

CODED

Date: 10/20, 1960, Driller: James A. White County: Rankin
(Name)


- (1) Owner of Land: Archib Dunham
(Name)
Florenal
(Address)
- (2) Location: 3 1/2 1/4, S 1/4, Sec. 25 T3R1
5 miles south of Florenal
(distance) (direction) (Nearest Town)
- (3) Topography: X
(Hilly) (Flat) (Level)
- (4) Purpose of Well: Domestic
(Domestic Irrigation
Municipal, Industrial, Other)

Description & Color of Materials Sand, Clay, Red Clay, Shell, etc.	Thick- ness Feet	Depth Feet
<u>Red clay</u>	<u>10</u>	<u>10</u>
<u>white chalk</u>	<u>20</u>	<u>30</u>
<u>Blue Shell</u>	<u>110</u>	<u>140</u>
<u>Sand</u>	<u>10</u>	<u>150</u>

Information upon completion of well:

- (1) Diameter 2 inches.
- (2) Total Depth 150 feet.
- (3) Water Level 55 feet below top of ground.
- (4) Cased to 84, Size 2"
- (5) Screen: Size open, Length _____
- (6) Were any formations sealed against pollution?
_____ yes, _____ no.

CODED

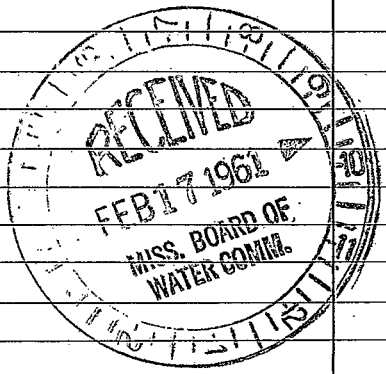

If YES depth of formation _____

Why _____

Drillers Remarks: _____

Well No.

(Use Back Side)

