

RANKIN
T 14
4-68

MISSISSIPPI
BOARD OF WATER COMMISSIONERS
416 North State Street
Jackson, Mississippi 39201

CODED

WATER WELL DRILLERS LOG

April 75 19 68 Burney Water Well Service, Inc. Rankin
date well completed firm name county well located

LANDOWNER: E. H. Brinson

description of formations encountered

from

to

Route 2, Bbx 83

Red clay top soil

0

14

Terry, Miss.

Red sand

14

22

(mailing address)

White sand

22

51

Water sand

51

86

WELL LOCATION:

sec. 21 T 3 N R 1 E
6 miles East of Terry
(distance) (direction) (nearest town)

WELL PURPOSE: Home
(home, irrigation, municipal, industrial)

WELL COMPLETION DATA:

- (1) diameter (inches) 6"
- (2) total depth (feet) 86'
- (3) static water level (feet) 52 below top of ground.
- (4) casing 4" PVC, 80'
(material) (depth)
if telescope see back.
(size)
- (5) screen 6' 80'
(length) (depth to top)
2 1/2" Johnson SS. No. 10
(size) (material)
- (6) pump 1/2 250 GPH
(HP) (yield gpm)
electric
(type power)
- (7) electric log no
(yes or no)
(organization running log)
- (8) how well bottom plugged
LHT Backwash valve

CODED




DRILLERS REMARKS:

If well telescopes please sketch and show depths.

GROUND LEVEL

80' 4" PVC Casing

6' - 1/2" Johnson
SS, Screen
NO. 10 SHOT ↓
L.H.T. Break wash
Value

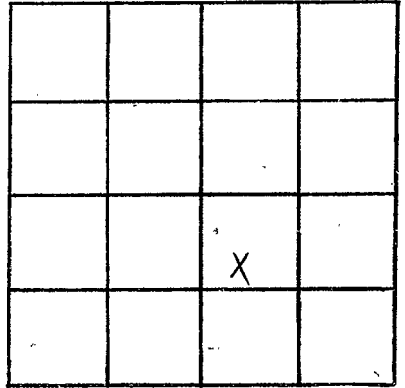

SECTION 21

Please indicate well location X.

ADDITIONAL INFORMATION

If more than one screen,
show locations of each on sketch.