

T 15

5-12-66

WATER WELL DRILLERS LOG **CODED**

Date: May 12, 1966, Driller: Burney Water Well Serv. Inc. Rankin County

(Name)

(1) Owner of Land: U. S. Bridges  
(Name)

Rt. 2 Box 72 Terry, Mississippi  
(Address)

(2) Location: 1/4, 1/4, Sec. 20 T3R1

7 miles East of Terry  
(distance) (direction) (Nearest Town)

(3) Topography: Hilly  
(Hilly) (Flat) (Level)

(4) Purpose of Well: Domestic  
(Domestic Irrigation  
Municipal, Industrial, Other)

Information upon completion of well:

(1) Diameter 6" inches.

(2) Total Depth 62' feet.

(3) Water Level 34' feet below top of ground.

(4) Cased to 55', Size 4"

(5) Screen: Size 4", Length 5'

(6) Were any formations sealed against pollution?

X yes, \_\_\_\_\_ no.

If YES depth of formation From surface


Why To prevent surface pollution

Drillers Remarks: Sanitary well seal

used.

Description & Color of Materials Sand, Clay, Red Clay, Shell, etc.	Thick- ness Feet	Depth Feet
Top soil & red clay	8	8
Yellow & White sand	16	26
Water strata	15	41
Hard grey clay	21	62

**CODED**

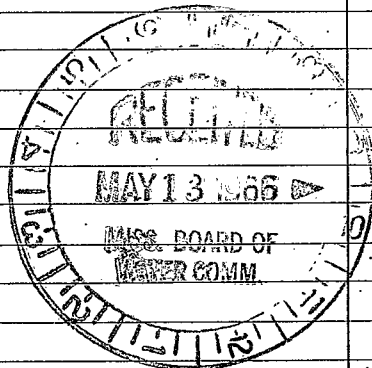

(Use Back Side)

Well No.

