

RANKIN MISSISSIPPI BOARD OF WATER COMMISSIONERS

T

T16

6-26-64

WATER WELL DRILLERS

CODER

Rankin
~~St. Louis~~

Date: 6/26/, 1964, Driller: Just Dalg. Sec. County St. Louis
 (Name)

(1) Owner of Land: Henry Gibson
 (Name)
Rt 2 Florence, Miss
 (Address)

(2) Location: 1/4, 1/4, Sec. 14 T3 R1
6 miles S. west of Florence
 (distance) (direction) (Nearest Town)

(3) Topography: (Hilly) (Flat) (Level)

(4) Purpose of Well: Home
 (Domestic Irrigation
 Municipal, Industrial, Other)

Description & Color of Materials Sand, Clay, Red Clay, Shell, etc.	Thick- ness Feet	Depth Feet
Brown Clay	0	12
band + shls Clay		22
By Clay + shls F. band		32
Blue clay		82
Clay + shls Rocks		112
Clay + shls Mely band		142
Clay		202
Clay + shls Sand & shell		225
Rocks + Clay		232
Clay + shls Rock		248
Fine Sand		252
Shals + shls Fine sand		278
Fine Sand		285

Information upon completion of well:

(1) Diameter 2 inches.

(2) Total Depth 285 feet.

(3) Water Level 36 feet below top of ground.

(4) Cased to 275, Size 2"

(5) Screen: Size 2", Length 10 ft


(6) Were any formations sealed against pollution?
 _____ yes, no.

If YES depth of formation _____

Why _____

Drillers Remarks: _____

CODER

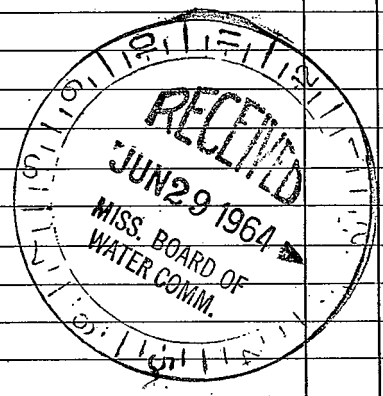

(Use Back Side)

Well No.

100

100

100